




Taiwan Semiconductor Manufacturing Company Ltd.

No.8, Li-Hisn Rd.6, Science-Based Industrial Park, Hsin-Chu, Taiwan 300 R.O.C.

Submittal Comments Summary

Design

廠商名稱：漢唐集成股份有限公司 (Co. Ltd.) United Integrated Services	送審時間： (Date) 2025.01.06	TSMC DC No.: F22P2-S-220-031-2	
送審系統合約名稱 (Package)：F22P2 MEP & PX System - MEP Mechanical			
Subject：Equipment Schedule table -2			
TSMC 彙總審核意見 (TSMC comments)：			
正本： To: 副本： C.C.:			
戳章 (Stamp)：			
Design Engineer	Construction Engineer	Construction Sec. Mgr.	Construction Project Mgr.

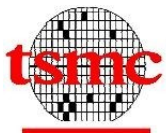

Taiwan Semiconductor Manufacturing Company Ltd.

25, Li-Hsin Rd., Science-Based Industrial Park, Hsin-Chu, Taiwan 300 R.O.C.

Tel : 886-3-563-6688 Ext.708-3210 Fax : 886-3-578-5890

Submittal Comments Summary

Design

廠商名稱：漢唐集成股份有限公司 (Co. Ltd.)	送審時間：2024/12/16 (Date)	TSMC DC No.: F22P2-S-220-031-1
-------------------------------	---------------------------	--------------------------------

送審系統名稱 (Content): Equipment Schedule table -2

TSMC 彙總審核意見 (TSMC comments):

?/機械管理課 張皓浦(NO EXCEPTIONS NOTED) 2024/12/16 11:26

?/機械工程二課 盧勁甫(MAKE CORRECTIONS NOTED) 2024/12/19 10:09

CUP L40 柴油室壁扇須採用為防爆型・請確認設備是否符合

?/水處理工程一課 楊蹟翰(NO EXCEPTIONS NOTED) 2024/12/20 08:28

?/水處理工程一課 王弘柚(NO EXCEPTIONS NOTED) 2024/12/20 08:35

?/機械管理課 陳正賢(NO EXCEPTIONS NOTED) 2024/12/20 16:38

?/機械工程一課 黃柏勛(NO EXCEPTIONS NOTED) 2024/12/23 14:35

正本：漢唐集成股份有限公司

副本：

To:

C.C.:

戳章 (Stamp):

☐ NO EXCEPTIONS NOTED

☒ MAKE CORRECTIONS NOTED

☐ REVISE AND RESUBMIT

☐ SUBMIT ITEMS AS NOTED

Checking is only for general conformance with the design concept of the project and general compliance with the information given in the contract documents. Any action shown is subject to the requirements of the plans and specifications. Contractor is responsible for dimensions which shall be confirmed and correlated at the job site, fabrication processes and techniques of construction, coordination of the work with that of all other trades and the satisfactory performance of the work,



Project Team of Design & Construction Department

tsmc F22P2 MEP PROJECT SUBMITTAL RECOMMENT

F22P2-S-220-031-2 Equipment Schedule table -2

TSMC 審核意見	UIS 回覆
1. CUP L40 柴油室壁扇須採用為防爆型，請確認設備是否符合	1. 遵照辦理，詳修正後圖號:F22P1-M-1-C-04。 (Page #7)

TSMC Submittal Plan				
Project Name:	Fab22 Phase-2	Date:	2024/8/20	
Package Name:	MEP & PX System - MEP Mechanical	Vendor:	漢唐集成股份有限公司	
Design				
Subject	Expected Date	Submittal Attachment		
		CD/Floppy	Drawing	Sample
System Flow Diagram - 5℃ 13℃ Chilled & Condenser Water System				
System Flow Diagram - 12℃ 20℃ Chilled & Condenser Water System				
System Flow Diagram - 35℃ 29℃ Warm Water System				
Equipment Schedule table -2	2024/12/8			
System Flow Diagram - Cooling Tower Condenser Water System				
System Flow Diagram - Cooling Tower Filtrations System				
System Flow Diagram - HVAC Chemical System				
System Flow Diagram - Piping System				
System Flow Diagram - Ducting System				
System Flow Diagram - CO2 System				
System Flow Diagram - De-smoke System				
System Flow Diagram - UPW DI Make-up Water System				
System Flow Diagram - Natural Gas System				
Drawings_CUP Area Layout	2024/12/8			
Drawings_FAB Area Layout	2024/12/8			
Drawings_HPM Area Layout	2024/12/8			
Others				
五年防蝕計劃書	2025/4/30			
設備功能運轉檢測程序及標準(含應用表單)(試車計畫書)	2025/4/30			

Serial Number: 202303231031-13 148411


材料/設備 送審規格差異比較表

材料/設備 名稱 (請註明使用地點、設備、系統)	RFP			F20P1			F22P1			F22P2			是否符 合 RFP	是否與 前廠相 同	備註/差異說明 (如廠牌型號與前廠使用不同請詳細說 明更換之原因)
	廠牌	型號	規格	廠牌	型號	規格	廠牌	型號	規格	廠牌	型號	規格			
Equipment Schedule table -2	NA	NA	NA	uis	uis	同18P8設計	uis	uis	同20P1設計	uis	uis	同22P1設計	NA	Yes	

1	2	3	4	5	6	7	8	9	10	11	12	13	14																	
PACKAGED AIR HANDLING UNIT SCHEDULE 1																														
UNIT MARK	LOCATION	SERVICE	QTY	FAN				COOLING COIL						MOTOR		FILTER EFF. %		REMARKS												
				TYPE	CMH	ESP(pa)	RPM	CAP.(KW)		EAT/°C		WB	EWT °C	LWT °C	L/S	HP	POWER SOURCE		TYPE	PRE.	FINAL									
								TOTAL	SENSIBLE	DB	WB																			
22P2-C10P-PAH3-AH01	CUP L10	CHILLER ROOM	1	FORWARD CURVED	20100	-	-	199	129	29.0	20.7	5.0	13.3	5.85	7.5	3/460/60	-	35	-	MOTOR: IE4; 上直吹型, 含風管型偵煙探測器										
22P2-C10P-PAH3-AH02	CUP L10	CHILLER ROOM	1	FORWARD CURVED	20100	-	-	199	129	29.0	20.7	5.0	13.3	5.85	7.5	3/460/60	-	35	-	MOTOR: IE4; 上直吹型, 含風管型偵煙探測器										
22P2-C10P-PAH3-AH03	CUP L10	CHILLER ROOM	1	FORWARD CURVED	20100	-	-	199	129	29.0	20.7	5.0	13.3	5.85	7.5	3/460/60	-	35	-	MOTOR: IE4; 上直吹型, 含風管型偵煙探測器										
22P2-C10P-PAH3-AH04	CUP L10	CHILLER ROOM	1	FORWARD CURVED	20100	-	-	199	129	29.0	20.7	5.0	13.3	5.85	7.5	3/460/60	-	35	-	MOTOR: IE4; 上直吹型, 含風管型偵煙探測器										
22P2-C10Q-PAH3-AH05	CUP L10	CHILLER ROOM	1	FORWARD CURVED	20100	-	-	199	129	29.0	20.7	5.0	13.3	5.85	7.5	3/460/60	-	35	-	MOTOR: IE4; 上直吹型, 含風管型偵煙探測器										
22P2-C10Q-PAH3-AH06	CUP L10	CHILLER ROOM	1	FORWARD CURVED	20100	-	-	199	129	29.0	20.7	5.0	13.3	5.85	7.5	3/460/60	-	35	-	MOTOR: IE4; 上直吹型, 含風管型偵煙探測器										
22P2-C10Q-PAH3-AH07	CUP L10	CHILLER ROOM	1	FORWARD CURVED	20100	-	-	199	129	29.0	20.7	5.0	13.3	5.85	7.5	3/460/60	-	35	-	MOTOR: IE4; 上直吹型, 含風管型偵煙探測器										
22P2-C10Q-PAH3-AH08	CUP L10	CHILLER ROOM	1	FORWARD CURVED	20100	-	-	199	129	29.0	20.7	5.0	13.3	5.85	7.5	3/460/60	-	35	-	MOTOR: IE4; 上直吹型, 含風管型偵煙探測器										
22P2-C10Q-PAH3-AH09	CUP L10	CHILLER ROOM	1	FORWARD CURVED	20100	-	-	199	129	29.0	20.7	5.0	13.3	5.85	7.5	3/460/60	-	35	-	MOTOR: IE4; 上直吹型, 含風管型偵煙探測器										
22P2-C10P-PAH3-AH10	CUP L10	CDA ROOM	1	FORWARD CURVED	24000	250	-	237	154	29.0	20.7	5.0	13.3	6.9	15	3/460/60	-	35	-	MOTOR: IE4; 20240702										
22P2-C10P-PAH3-AH11	CUP L10	CDA ROOM	1	FORWARD CURVED	24000	250	-	237	154	29.0	20.7	5.0	13.3	6.9	15	3/460/60	-	35	-	MOTOR: IE4; 20240702, tsmc 要求一部臥式風機, 機房增加偵煙探測器										
22P2-C10P-PAH3-AH12	CUP L10	CDA ROOM	1	FORWARD CURVED	24000	250	-	237	154	29.0	20.7	5.0	13.3	6.9	15	3/460/60	-	35	-	MOTOR: IE4; 含風管型偵煙探測器										
22P2-C20P-PAH3-AH13	CUP L20	CDA ROOM	1	FORWARD CURVED	20100	250	-	199	129	29.0	20.7	5.0	13.3	5.85	10	3/460/60	-	35	-	MOTOR: IE4; 含風管型偵煙探測器										
22P2-C20P-PAH3-AH14	CUP L20	CDA ROOM	1	FORWARD CURVED	20100	250	-	199	129	29.0	20.7	5.0	13.3	5.85	10	3/460/60	-	35	-	MOTOR: IE4; 含風管型偵煙探測器										
22P2-C20Q-PAH3-AH15	CUP L20	PA ROOM	1	FORWARD CURVED	13800	350	-	136	87	29.0	20.7	5.0	13.3	3.9	7.5	3/460/60	-	35	-	MOTOR: IE4; 進, 出風皆須銜接風管(側拉濾網) ; 含風管型偵煙探測器										
22P2-C20Q-PAH3-AH16	CUP L20	PA ROOM	1	FORWARD CURVED	13800	350	-	136	87	29.0	20.7	5.0	13.3	3.9	7.5	3/460/60	-	35	-	MOTOR: IE4; 進, 出風皆須銜接風管(側拉濾網) ; 含風管型偵煙探測器										
22P2-C30Q-PAH3-AH17	CUP L30	I/O ROOM	1	FORWARD CURVED	13800	350	-	138	87	29.0	20.7	5.0	13.3	3.9	7.5	3/460/60	-	35	-	MOTOR: IE4; 進, 出風皆須銜接風管(側拉濾網) ; 含風管型偵煙探測器										
22P2-C30Q-PAH3-AH18	CUP L30	I/O ROOM	1	FORWARD CURVED	13800	350	-	138	87	29.0	20.7	5.0	13.3	3.9	7.5	3/460/60	-	35	-	MOTOR: IE4; 進, 出風皆須銜接風管(側拉濾網) ; 含風管型偵煙探測器										
ELECTRICAL/UPS ROOM PACKAGED AIR HANDLING UNIT SCHEDULE																														
UNIT MARK	LOCATION	SERVICE	QTY	FAN				COOLING COIL						MOTOR		FILTER EFF. %		REMARKS												
				TYPE	CMH	ESP(pa)	RPM	CAP.(KW)		EAT/°C		WB	EWT °C	LWT °C	L/S	HP	POWER SOURCE		TYPE	PRE.	FINAL									
								TOTAL	SENSIBLE	DB	WB																			
22P2-C20Q-PAH3-AH22~23	CUP L20	C20P1	2	FORWARD CURVED	11000	250	-	108	70	29.0	20.7	5.0	13.3	3.1	5	3/460/60	-	35	-	MOTOR: IE4										
22P2-C20Q-PAH3-AH24	CUP L20	C20P2	1	FORWARD CURVED	20100	250	-	199	129	29.0	20.7	5.0	13.3	5.85	10	3/460/60	-	35	-	MOTOR: IE4										
22P2-C20Q-PAH3-AH25	CUP L20	C20P2	1	FORWARD CURVED	20100	250	-	199	129	29.0	20.7	5.0	13.3	5.85	10	3/460/60	-	35	-	MOTOR: IE4; (FUTURE)										
22P2-C20P-PAH3-AH26~27	CUP L20	C20P2	2	FORWARD CURVED	20100	250	-	199	129	29.0	20.7	5.0	13.3	5.85	10	3/460/60	-	35	-	MOTOR: IE4										
22P2-C20P-PAH3-AH28~30	CUP L20	C20P3	3	FORWARD CURVED	13800	250	-	136	87	29.0	20.7	5.0	13.3	3.9	7.5	3/460/60	-	35	-	MOTOR: IE4										
22P2-C20P-PAH3-AH31	CUP L20	C20P3	1	FORWARD CURVED	13800	250	-	136	87	29.0	20.7	5.0	13.3	3.9	7.5	3/460/60	-	35	-	MOTOR: IE4; (FUTURE)										
22P2-C30Q-PAH3-AH32~33	CUP L30	C30P1	2	FORWARD CURVED	13800	250	-	136	87	29.0	20.7	5.0	13.3	3.9	7.5	3/460/60	-	35	-	MOTOR: IE4										
22P2-C30Q-PAH3-AH34~35	CUP L30	C30P2	2	FORWARD CURVED	11000	250	-	108	70	29.0	20.7	5.0	13.3	3.1	5	3/460/60	-	35	-	MOTOR: IE4										
22P2-C30P-PAH3-AH36	CUP L30	C30P3	2	FORWARD CURVED	13800	250	-	136	87	29.0	20.7	5.0	13.3	3.9	7.5	3/460/60	-	35	-	MOTOR: IE4										
22P2-C30Q-PAH3-AH37	CUP L30	C30P3	1	FORWARD CURVED	13800	250	-	136	87	29.0	20.7	5.0	13.3	3.9	7.5	3/460/60	-	35	-	MOTOR: IE4; (FUTURE)										
22P2-C40Q-PAH3-AH48~49	CUP L40	C40P1	2	FORWARD CURVED	11000	250	-	108	70	29.0	20.7	5.0	13.3	3.1	5	3/460/60	-	35	-	MOTOR: IE4 20241212, CUB L30 RELAYOUT										
22P2-C40Q-PAH3-AH50	CUP L40	C40P1	1	FORWARD CURVED	11000	250	-	108	70	29.0	20.7	5.0	13.3	3.1	5	3/460/60	-	35	-	MOTOR: IE4; (FUTURE)										
22P2-C40Q-PAH3-AH51	CUP L40	C40P1	1	FORWARD CURVED	11000	250	-	108	70	29.0	20.7	5.0	13.3	3.1	5	3/460/60	-	35	-	MOTOR: IE4										
PACKAGED AIR HANDLING UNIT SCHEDULE 2																														
UNIT MARK	LOCATION	SERVICE	FAN				COOLING COIL										DEHUMIDIFIER COIL													
			TYPE	CMH	ESP(pa)	RPM	FACE VEL. M/S MAX.	ROWS/FP	CAP.KW	EAT		LAT		AIR Δ P Pa	L/S	EWT °C	LWT °C	WTR Δ P KPa	FACE VEL. M/S MAX.	ROWS/FP	CAP.KW	EAT		LAT		AIR Δ P Pa	L/S	EWT °C	LWT °C	WTR Δ P KPa
22P2-C10P-PAH3-AH10	CUP L10	CDA ROOM	FORWARD CURVED	24000	650	-	-	-	158	55	27.4	36	22.1	-	6.3	29	35	-	2.66	-	280	36	22.1	12.5	12.4	-	6.9	5	13.5	-
22P2-C10P-PAH3-AH11	CUP L10	CDA ROOM	FORWARD CURVED	24000	650	-	-	-	158	55	27.4	36	22.1	-	6.3	29	35	-	2.66	-	280	36	22.1	12.5	12.4	-	6.9	5	13.5	-
PACKAGED AIR HANDLING UNIT SCHEDULE 2																														
MOTOR			FILTER EFF. %		REMARKS																									
HP	POWER SOURCE	TYPE	PRE.	FINAL																										
15	3/460/60	TEFC	35	-																										
15	3/460/60	TEFC	35	-	MOTOR: IE4; 進, 出風皆須銜接風管 ; 含風管型偵煙探測器 20241108																									
15	3/460/60	TEFC	35	-	MOTOR: IE4; 進, 出風皆須銜接風管 ; 含風管型偵煙探測器																									
TERMINAL UNIT SCHEDULE																														
UNIT MARK	SERVICE	TYPE	AIR FLOW CMH		INLET SIZE mm	CONTROL		RADIATED SOUND POWER, dB (NOTE 1)								REMARKS														
			MAX.	MIN.		TYPE	FUNCTION	VOLTAGE	125Hz	250Hz	500Hz	1000Hz	2000Hz	4000Hz	QTY															
TVB-4	GENERAL OFFICE	SINGLE DUCT	360	36	100	TEMPERATURE-INDEPENDENT ANALOG ELECTRONIC	MODULATION	-	-	-	-	-	-	-	-	-	-	THE RADIATED SOUND POWER SHOWN HERE IS BASED ON THE 1.5 x MINIMUM STATIC PRESSURE.												
TVB-5	GENERAL OFFICE	SINGLE DUCT	594	72	125	TEMPERATURE-INDEPENDENT ANALOG ELECTRONIC	MODULATION	-	-	-	-	-	-	-	-	-	-	THE RADIATED SOUND POWER SHOWN HERE IS BASED ON THE 1.5 x MINIMUM STATIC PRESSURE.												
TVB-6	GENERAL OFFICE	SINGLE DUCT	774	90	150	TEMPERATURE-INDEPENDENT ANALOG ELECTRONIC	MODULATION	-	-	-	-	-	-	-	-	-	2	THE RADIATED SOUND POWER SHOWN HERE IS BASED ON THE 1.5 x MINIMUM STATIC PRESSURE.												
TVB-7	GENERAL OFFICE	SINGLE DUCT	1080	108	175	TEMPERATURE-INDEPENDENT ANALOG ELECTRONIC	MODULATION	-	-	-	-	-	-	-	-	-	-	THE RADIATED SOUND POWER SHOWN HERE IS BASED ON THE 1.5 x MINIMUM STATIC PRESSURE.												
TVB-8	GENERAL OFFICE	SINGLE DUCT	1368	144	200	TEMPERATURE-INDEPENDENT ANALOG ELECTRONIC	MODULATION	-	-	-	-	-	-	-	-	-	5	THE RADIATED SOUND POWER SHOWN HERE IS BASED ON THE 1.5 x MINIMUM STATIC PRESSURE.												
TVB-10	GENERAL OFFICE	SINGLE DUCT	2304	234	250	TEMPERATURE-INDEPENDENT ANALOG ELECTRONIC	MODULATION	-	-	-	-	-	-	-	-	-	-	THE RADIATED SOUND POWER SHOWN HERE IS BASED ON THE 1.5 x MINIMUM STATIC PRESSURE.												
TVB-12	GENERAL OFFICE	SINGLE DUCT	3600	360	300	TEMPERATURE-INDEPENDENT ANALOG ELECTRONIC	MODULATION	-	-	-	-	-	-	-	-	-	8	THE RADIATED SOUND POWER SHOWN HERE IS BASED ON THE 1.5 x MINIMUM STATIC PRESSURE.												
TVB-14	GENERAL OFFICE	SINGLE DUCT	5400	540	350	TEMPERATURE-INDEPENDENT ANALOG ELECTRONIC	MODULATION	-	-	-	-	-	-	-	-	-	-	THE RADIATED SOUND POWER SHOWN HERE IS BASED ON THE 1.5 x MINIMUM STATIC PRESSURE.												
TVB-16	GENERAL OFFICE	SINGLE DUCT	6804	684	400	TEMPERATURE-INDEPENDENT ANALOG ELECTRONIC	MODULATION	-	-	-	-	-	-	-	-	-	-	THE RADIATED SOUND POWER SHOWN HERE IS BASED ON THE 1.5 x MINIMUM STATIC PRESSURE.												
20241129																														
1	2	3	4	5	6	7	8	9	10	11	12	13	14																	

KEY PLAN

PACKAGED SUPPLY FAN SCHEDULE																			
UNIT MARK	LOCATION	SERVICE	QTY	FAN						MOTOR			FILTER EFF.%		CHEMICAL FILTER			REMARKS	
				TYPE	CMH	TSP(pp)	WHEEL TYPE	RPM	DRIVE	BHP	KW	POWER SOURCE	TYPE	PRE.	FINAL	STAGE 1	STAGE 2		STAGE 3
22P2-FB2H-SF2-PK01	22P2B FAB LB2	PCW/UPW/WWT GEX RECOVERY	1	DOUBLE SUCTION	10000	500	FORWARD INCLINED	-	BELT	-	7.5	3/460/60	TEFC	-	-	SPACE	-	-	MOTOR: IE4, 全密封及上鎖風扇門開關, 隔震器適用 MERV 13 室內型, 含預留一組V-type化學濾網在箱段外框(比照SP6作法) (WITHOUT COOLING COIL維修時電壓: 1ø/120V/60HZ
22P2-FB2A-SF1-PK01	22P2A FAB LB2	PCW/UPW/WWT GEX RECOVERY	1	DOUBLE SUCTION	10000	500	FORWARD INCLINED	-	BELT	-	7.5	3/460/60	TEFC	-	-	SPACE	-	-	

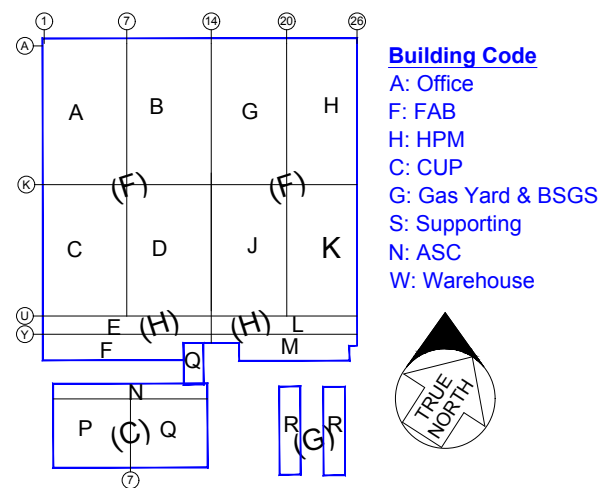

AIR HANDLING UNIT SCHEDULE																							
UNIT MARK	LOCATION	SERVICE	QTY	FAN				COOLING COIL								MOTOR			FILTER EFF.%		REMARKS		
				TYPE	CMH	ESP(po)	RPM	FACE VEL. M/S MAX.	CAP.(KW)	EAT'C		LAT'C		EWT °C	LWT °C	L/S	HP	POWER SOURCE	TYPE	PRE.		FINAL	
22P2-FB2H-AHU2-AH01	22P2B FAB LB2	PCW & UPW	1	BACKWARD CURVED	45400	750	—	2.6	846	35.0	29.4	14.5	14.5	5.0	13.5	23.9	40	3/460/60	TEFC	35	85	MOTOR: IE4; (預留—直V—type化學達網空箱段外箱) (附進風,出風,外氣風門開關)(達網應用 MERV 13)	
22P2-FB2H-AHU2-AH02	22P2B FAB LB2	PCW & UPW	1	BACKWARD CURVED	45400	750	—	2.6	846	35.0	29.4	14.5	14.5	5.0	13.5	23.9	40	3/460/60	TEFC	35	85	MOTOR: IE4; (預留—直V—type化學達網空箱段外箱) (附進風,出風,外氣風門開關)(達網應用 MERV 13)	
22P2-FB2K-AHU2-AH03	22P2B FAB LB2	PCW & UPW	1	BACKWARD CURVED	45400	750	—	2.6	846	35.0	29.4	14.5	14.5	5.0	13.5	23.9	40	3/460/60	TEFC	35	85	MOTOR: IE4; (預留—直V—type化學達網空箱段外箱) (附進風,出風,外氣風門開關)(達網應用 MERV 13)	
22P2-FB2K-AHU2-AH04	22P2B FAB LB2	PCW & UPW	1	BACKWARD CURVED	45400	750	—	2.6	846	35.0	29.4	14.5	14.5	5.0	13.5	23.9	40	3/460/60	TEFC	35	85	MOTOR: IE4; (預留—直V—type化學達網空箱段外箱) (附進風,出風,外氣風門開關)(達網應用 MERV 13)	
22P2-F10H-AHU2-AH05	22P2B FAB L10	UTILITY SUBFAB	1	BACKWARD CURVED	60000	500	—	2.6	1118	35.0	29.4	14.5	14.5	5.0	13.5	31.6	40	3/460/60	TEFC	35	85	MOTOR: IE4; (附進風,出風,外氣風門開關)(達網應用 MERV 13)	
22P2-F10H-AHU2-AH06	22P2B FAB L10	UTILITY SUBFAB	1	BACKWARD CURVED	60000	500	—	2.6	1118	35.0	29.4	14.5	14.5	5.0	13.5	31.6	40	3/460/60	TEFC	35	85	MOTOR: IE4; (附進風,出風,外氣風門開關)(達網應用 MERV 13)	
22P2-F10H-AHU2-AH07	22P2B FAB L10	UTILITY SUBFAB	1	BACKWARD CURVED	60000	500	—	2.6	1118	35.0	29.4	14.5	14.5	5.0	13.5	31.6	40	3/460/60	TEFC	35	85	MOTOR: IE4; (附進風,出風,外氣風門開關)(達網應用 MERV 13)	
22P2-F10H-AHU2-AH08	22P2B FAB L10	UTILITY SUBFAB	1	BACKWARD CURVED	60000	500	—	2.6	1118	35.0	29.4	14.5	14.5	5.0	13.5	31.6	40	3/460/60	TEFC	35	85	MOTOR: IE4; (附進風,出風,外氣風門開關)(達網應用 MERV 13)	
22P2-F10K-AHU2-AH09	22P2B FAB L10	UTILITY SUBFAB	1	BACKWARD CURVED	60000	500	—	2.6	1118	35.0	29.4	14.5	14.5	5.0	13.5	31.6	40	3/460/60	TEFC	35	85	MOTOR: IE4; (附進風,出風,外氣風門開關)(達網應用 MERV 13)	
22P2-F10K-AHU2-AH10	22P2B FAB L10	UTILITY SUBFAB	1	BACKWARD CURVED	60000	500	—	2.6	1118	35.0	29.4	14.5	14.5	5.0	13.5	31.6	40	3/460/60	TEFC	35	85	MOTOR: IE4; (附進風,出風,外氣風門開關)(達網應用 MERV 13)	
22P2-FB2A-AHU1-AH01	22P2A FAB LB2	PCW & UPW	1	BACKWARD CURVED	45400	750	—	2.6	846	35.0	29.4	14.5	14.5	5.0	13.5	23.9	40	3/460/60	TEFC	35	85	MOTOR: IE4; (預留—直V—type化學達網空箱段外箱) (附進風,出風,外氣風門開關)(達網應用 MERV 13)	
22P2-FB2A-AHU1-AH02	22P2A FAB LB2	PCW & UPW	1	BACKWARD CURVED	45400	750	—	2.6	846	35.0	29.4	14.5	14.5	5.0	13.5	23.9	40	3/460/60	TEFC	35	85	MOTOR: IE4; (預留—直V—type化學達網空箱段外箱) (附進風,出風,外氣風門開關)(達網應用 MERV 13)	
22P2-FB2C-AHU1-AH03	22P2A FAB LB2	PCW & UPW	1	BACKWARD CURVED	45400	750	—	2.6	846	35.0	29.4	14.5	14.5	5.0	13.5	23.9	40	3/460/60	TEFC	35	85	MOTOR: IE4; (預留—直V—type化學達網空箱段外箱) (附進風,出風,外氣風門開關)(達網應用 MERV 13)	
22P2-FB2C-AHU1-AH04	22P2A FAB LB2	PCW & UPW	1	BACKWARD CURVED	45400	750	—	2.6	846	35.0	29.4	14.5	14.5	5.0	13.5	23.9	40	3/460/60	TEFC	35	85	MOTOR: IE4; (預留—直V—type化學達網空箱段外箱) (附進風,出風,外氣風門開關)(達網應用 MERV 13)	
22P2-F10A-AHU1-AH05	22P2A FAB L10	UTILITY SUBFAB	1	BACKWARD CURVED	60000	500	—	2.6	1118	35.0	29.4	14.5	14.5	5.0	13.5	31.6	40	3/460/60	TEFC	35	85	MOTOR: IE4; (附進風,出風,外氣風門開關)(達網應用 MERV 13)	
22P2-F10A-AHU1-AH06	22P2A FAB L10	UTILITY SUBFAB	1	BACKWARD CURVED	60000	500	—	2.6	1118	35.0	29.4	14.5	14.5	5.0	13.5	31.6	40	3/460/60	TEFC	35	85	MOTOR: IE4; (附進風,出風,外氣風門開關)(達網應用 MERV 13)	
22P2-F10A-AHU1-AH07	22P2A FAB L10	UTILITY SUBFAB	1	BACKWARD CURVED	60000	500	—	2.6	1118	35.0	29.4	14.5	14.5	5.0	13.5	31.6	40	3/460/60	TEFC	35	85	MOTOR: IE4; (附進風,出風,外氣風門開關)(達網應用 MERV 13)	
22P2-F10A-AHU1-AH08	22P2A FAB L10	UTILITY SUBFAB	1	BACKWARD CURVED	60000	500	—	2.6	1118	35.0	29.4	14.5	14.5	5.0	13.5	31.6	40	3/460/60	TEFC	35	85	MOTOR: IE4; (附進風,出風,外氣風門開關)(達網應用 MERV 13)	
22P2-F10C-AHU1-AH09	22P2A FAB L10	UTILITY SUBFAB	1	BACKWARD CURVED	60000	500	—	2.6	1118	35.0	29.4	14.5	14.5	5.0	13.5	31.6	40	3/460/60	TEFC	35	85	MOTOR: IE4; (附進風,出風,外氣風門開關)(達網應用 MERV 13) (FUTURE)	
22P2-F10C-AHU1-AH10	22P2A FAB L10	UTILITY SUBFAB	1	BACKWARD CURVED	60000	500	—	2.6	1118	35.0	29.4	14.5	14.5	5.0	13.5	31.6	40	3/460/60	TEFC	35	85	MOTOR: IE4; (附進風,出風,外氣風門開關)(達網應用 MERV 13)	
22P2-FB1D-AHU1-AH11	22P2A FAB LB1	WWT-A	1	BACKWARD CURVED	30000	500	—	2.6	267	26	20.3	11	11	5.0	13.5	7.5	20	3/460/60	TEFC	35	85	MOTOR: IE4; (附進風,出風,外氣風門開關)(達網應用 MERV 13)	
22P2-FB1D-AHU1-AH12	22P2A FAB LB1	WWT-A	1	BACKWARD CURVED	30000	500	—	2.6	267	26	20.3	11	11	5.0	13.5	7.5	20	3/460/60	TEFC	35	85	MOTOR: IE4; (附進風,出風,外氣風門開關)(達網應用 MERV 13)	
22P2-FB1J-AHU2-AH13	22P2B FAB LB1	WWT-B	1	BACKWARD CURVED	15000	500	—	2.6	133	26	20.3	11	11	5.0	13.5	3.8	15	3/460/60	TEFC	35	85	MOTOR: IE4; (附進風,出風,外氣風門開關)(達網應用 MERV 13)	
22P2-FB1J-AHU2-AH14	22P2B FAB LB1	WWT-B	1	BACKWARD CURVED	15000	500	—	2.6	133	26	20.3	11	11	5.0	13.5	3.8	15	3/460/60	TEFC	35	85	MOTOR: IE4; (附進風,出風,外氣風門開關)(達網應用 MERV 13)	
22P2-FB2H-AHU2-AH05	22P2B FAB LB2	PCW & UPW	1	BACKWARD CURVED	45400	750	—	2.6	846	35.0	29.4	14.5	14.5	5.0	13.5	23.9	40	3/460/60	TEFC	35	85	MOTOR: IE4; (預留—直V—type化學達網空箱段外箱) (附進風,出風,外氣風門開關)(達網應用 MERV 13)	
22P2-FB2H-AHU2-AH06	22P2B FAB LB2	PCW & UPW	1	BACKWARD CURVED	45400	750	—	2.6	846	35.0	29.4	14.5	14.5	5.0	13.5	23.9	40	3/460/60	TEFC	35	85	MOTOR: IE4; (預留—直V—type化學達網空箱段外箱) (附進風,出風,外氣風門開關)(達網應用 MERV 13)	

EXHAUST FAN SCHEDULE														
UNIT MARK	LOCATION	SERVICE	QTY	FAN						MOTOR			REMARKS	
				TYPE	CMH	ESP(pa)	WHEEL TYPE	RPM	DRIVE	BHP	KW	POWER SOURCE		TYPE
22P2-FB2H-EF2-F01	22P2B FAB LB2	UPW	1	SINGLE INLET CENTRIFUGAL FAN	10000	500	BACKWARD INCLINED	-	BELT	-	7.5	3/460/60	-	MOTOR: IE4; 落地型 (風車轆牛及葉輪材質SUS+內部COATING FRP+軸承外置)
22P2-FB2H-EF2-F02	22P2B FAB LB2	UPW	1	SINGLE INLET CENTRIFUGAL FAN	10000	500	BACKWARD INCLINED	-	BELT	-	7.5	3/460/60	-	MOTOR: IE4; 落地型 (STANDBY) (風車轆牛及葉輪材質SUS+內部COATING FRP+軸承外置)
22P2-F40G-EF2-F04	22P2B FAB L40	電梯機房	1	WALL MOUNTED	2300	62.5	PROPELLER	-	DIRECT	-	0.2	1/208/60	-	
22P2-F40G-EF2-F05	22P2B FAB L40	電梯機房	1	WALL MOUNTED	2300	62.5	PROPELLER	-	DIRECT	-	0.2	1/208/60	-	
22P2-F40J-EF2-F06	22P2B FAB L40	電梯機房	1	WALL MOUNTED	2300	62.5	PROPELLER	-	DIRECT	-	0.2	1/208/60	-	
22P2-FB2A-EF1-F01	22P2A FAB LB2	UPW	1	SINGLE INLET CENTRIFUGAL FAN	10000	500	BACKWARD INCLINED	-	BELT	-	7.5	3/460/60	-	MOTOR: IE4; 落地型 (風車轆牛及葉輪材質SUS+內部COATING FRP+軸承外置)
22P2-FB2A-EF1-F02	22P2A FAB LB2	UPW	1	SINGLE INLET CENTRIFUGAL FAN	10000	500	BACKWARD INCLINED	-	BELT	-	7.5	3/460/60	-	MOTOR: IE4; 落地型 (STANDBY) (風車轆牛及葉輪材質SUS+內部COATING FRP+軸承外置)
22P2-F10C-EF1-F03	22P2B FAB L10	消防機房	1	WALL MOUNTED	8000	62.5	PROPELLER	-	DIRECT	-	0.75	3/460/60	-	
22P2-F40B-EF1-F04	22P2A FAB L40	電梯機房	1	WALL MOUNTED	2300	62.5	PROPELLER	-	DIRECT	-	0.2	1/208/60	-	
22P2-F40B-EF1-F05	22P2A FAB L40	電梯機房	1	WALL MOUNTED	2300	62.5	PROPELLER	-	DIRECT	-	0.2	1/208/60	-	
22P2-F40D-EF1-F06	22P2A FAB L40	電梯機房	1	WALL MOUNTED	2300	62.5	PROPELLER	-	DIRECT	-	0.2	1/208/60	-	

[illegible]

1	2	3	4	5	6	7	8	9	10	11	12	13	14
---	---	---	---	---	---	---	---	---	----	----	----	----	----

CO2 EXHAUST FAN SCHEDULE

UNIT MARK	LOCATION	SERVICE	CMH	FAN			WHEEL TYPE	DRIVE	BHP	MOTOR			REMARKS
				TYPE	ESP Po	FRPM				VOLTAGE	TYPE		
22P2-FR1H-CEX2-F01	22P2B FAB LR1	ELECTRICAL ROOM	20000	INLINE FAN	500	—	BACKWARD INCLINED	BELT	—	5.5	3/460/60	TEFC	扇外架增型
22P2-FR1K-CEX2-F02	22P2B FAB LR1	ELECTRICAL ROOM	20000	INLINE FAN	500	—	BACKWARD INCLINED	BELT	—	5.5	3/460/60	TEFC	扇外架增型
22P2-FR1K-CEX2-F03	22P2B FAB LR1	ELECTRICAL ROOM	5000	INLINE FAN	500	—	BACKWARD INCLINED	BELT	—	1.5	3/460/60	TEFC	扇外架增型
22P2-FR1G-CEX2-F04	22P2B FAB LR1	ELECTRICAL ROOM	20000	INLINE FAN	500	—	BACKWARD INCLINED	BELT	—	5.5	3/460/60	TEFC	扇外架增型
22P2-FR1J-CEX2-F05	22P2B FAB LR1	ELECTRICAL ROOM	17000	INLINE FAN	500	—	BACKWARD INCLINED	BELT	—	5.5	3/460/60	TEFC	扇外架增型
22P2-FR1J-CEX2-F06	22P2B FAB LR1	ELECTRICAL ROOM	12000	INLINE FAN	500	—	BACKWARD INCLINED	BELT	—	5.5	3/460/60	TEFC	扇外架增型
22P2-FR1A-CEX1-F01	22P2B FAB LR1	ELECTRICAL ROOM	20000	INLINE FAN	500	—	BACKWARD INCLINED	BELT	—	5.5	3/460/60	TEFC	扇外架增型
22P2-FR1C-CEX1-F02	22P2B FAB LR1	ELECTRICAL ROOM	20000	INLINE FAN	500	—	BACKWARD INCLINED	BELT	—	5.5	3/460/60	TEFC	扇外架增型
22P2-FR1C-CEX1-F03	22P2B FAB LR1	ELECTRICAL ROOM	5000	INLINE FAN	500	—	BACKWARD INCLINED	BELT	—	1.5	3/460/60	TEFC	扇外架增型
22P2-FR1B-CEX1-F04	22P2A FAB LR1	ELECTRICAL ROOM	20000	INLINE FAN	500	—	BACKWARD INCLINED	BELT	—	5.5	3/460/60	TEFC	扇外架增型
22P2-FR1D-CEX1-F05	22P2A FAB LR1	ELECTRICAL ROOM	17000	INLINE FAN	500	—	BACKWARD INCLINED	BELT	—	5.5	3/460/60	TEFC	扇外架增型
22P2-FR1D-CEX1-F06	22P2A FAB LR1	ELECTRICAL ROOM	12000	INLINE FAN	500	—	BACKWARD INCLINED	BELT	—	5.5	3/460/60	TEFC	扇外架增型

UPW/DI BUFFER TANK SCHEDULE

UNIT MARK	SERVICE	QTY	MATERIAL	EFFECTIVE TANK CAPACITY (M ³)	DIMENSION (mm)	REMARKS
22P2-FB2H-DIW2-T01	22P2B UPW/DI MAKE UP TANK	1	SUS 316	15		
22P2-FB2A-DIW1-T01	22P2A UPW/DI MAKE UP TANK	1	SUS 316	15		

UPW/DI PUMP SCHEDULE

UNIT MARK	SERVICE	TYPE	SUCTION SIZE A	DISCHARGE SIZE A	FLOW L/S	HEAD M	BHP	RPM	MOTOR			FLUID	REMARKS
									POWER (KW)	VOLTAGE	TYPE		
22P2-FB2H-DIW2-P01	22P2B UPW/DI MAKE UP WATER SYSTEM	IN-LINE	100	100	17.5	68	-	3500	19	3/460/60	ODP	DI WATER	W/VFD,IE3 SUS 横
22P2-FB2H-DIW2-P02	22P2B UPW/DI MAKE UP WATER SYSTEM	IN-LINE	100	100	17.5	68	-	3500	19	3/460/60	ODP	DI WATER	W/VFD,IE3 SUS 横
22P2-FB2H-DIW2-P03	22P2B UPW/DI MAKE UP WATER SYSTEM	IN-LINE	100	100	17.5	68	-	3500	19	3/460/60	ODP	DI WATER	W/VFD,IE3 SUS 横(STANDBY)
22P2-FB2A-DIW1-P01	22P2A UPW/DI MAKE UP WATER SYSTEM	IN-LINE	100	100	17.5	68	-	3500	19	3/460/60	ODP	DI WATER	W/VFD,IE3 SUS 横
22P2-FB2A-DIW1-P02	22P2A UPW/DI MAKE UP WATER SYSTEM	IN-LINE	100	100	17.5	68	-	3500	19	3/460/60	ODP	DI WATER	W/VFD,IE3 SUS 横
22P2-FB2A-DIW1-P03	22P2A UPW/DI MAKE UP WATER SYSTEM	IN-LINE	100	100	17.5	68	-	3500	19	3/460/60	ODP	DI WATER	W/VFD,IE3 SUS 横(STANDBY)


JET INDUCE FAN SCHEDULE

UNIT MARK	LOCATION	SERVICE	QTY	FAN							MOTOR			REMARKS
				TYPE	CMH	ESP(pa)	WHEEL TYPE	RPM	DRIVE	BHP	HP	POWER SOURCE	TYPE	
IF	22P2 FAB LB1	LB1中央走廊	5	誘導式-INLINED	2500	150	FORWARD CURVED	-	-	-	0.5 HP	1/208/60	-	

AIR CURTAIN SCHEDULE

UNIT MARK	LOCATION	SERVICE	QTY	FAN		SIZE		MOTOR			REMARKS
				有效斷距離 (m)	CMM	W (mm)	H (mm)	W	POWER SOURCE	TYPE	
22P2-F10A-SF1-F01	22P2A FAB L10	FAB 出入口	1	4.0	53	1200	265	345	1/220/60	-	
22P2-F10A-SF1-F02	22P2A FAB L10	FAB 出入口	1	4.0	53	1200	265	345	1/220/60	-	
22P2-F10H-SF1-F01	22P2A FAB L10	FAB 出入口	1	4.0	53	1200	265	345	1/220/60	-	
22P2-F10H-SF1-F02	22P2A FAB L10	FAB 出入口	1	4.0	53	1200	265	345	1/220/60	-	

20241210

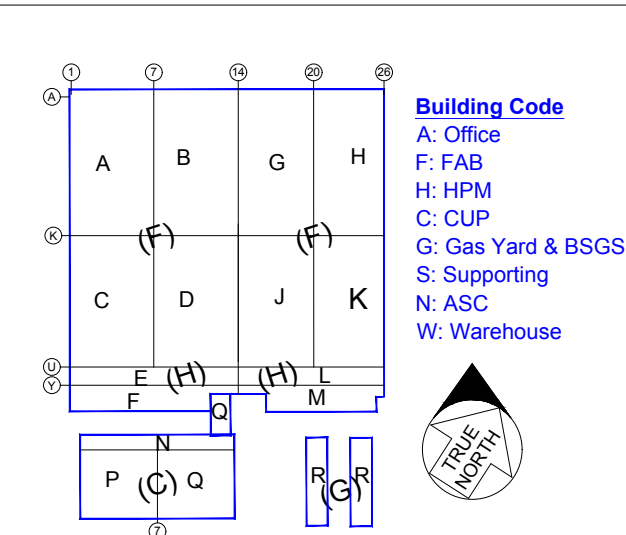[illegible]

版次 VER.	日期 DATE	修正者 REV.BY	修 正 REVISION
------------	------------	---------------	-----------------



台灣積體電路製造股份有限公司
Taiwan Semiconductor Manufacturing Company, Ltd.

ACCEPTANCE REVIEWED	DATE	ACCEPTANCE REVIEWED	DATE
---------------------	------	---------------------	------

CONTRACTOR

 漢唐集成股份有限公司
United Integrated Service

DRAWN ROGER YEH	DATE 2024/12/10	RECHECKED Steven Yu	DATE 2024/12/10
DESIGNED ROGER YEH	DATE 2024/12/10	APPROVED JOSEPH LEE	DATE 2024/12/10

TITLE
MECHANICAL SYSTEM EQUIPMENT SCHEDULE (11) HPM

PROJECT	FAB22 Phase 2 PROJECT
---------	-----------------------

PACKAGE NAME	MEP SYSTEM
--------------	------------

DRAWING NAME	F22P2-M-1-F-04
--------------	----------------

SCALE	UNIT
NOT TO SCALE	mm

FILE NAME	F22P2-M-1-F-04	Rev.
-----------	----------------	------

1	2	3	4	5	6	7	8	9	10	11	12	13	14																																																																																																																				
MAKE-UP AIR HANDLING UNIT SCHEDULE																																																																																																																																	
A	UNIT MARK	LOCATION	SERVICE	FAN						HEATING COIL						COOLING COIL																																																																																																																	
				CMH	ESP(pa)	TSP(po)	WHEEL TYPE	DRIVE	RPM	EFFICIENCY %	FACE VEL M/S MAX	ROWS/FP	CAP.KW	EAT DB°C	LAT DB°C	AIR Δ P Pa	L/S	EWT °C	LWT °C	WTR Δ P KPα	FACE VEL M/S MAX	ROWS/FP	CAP.KW	EAT DB°C	WB°C	DB°C	LAT DB°C	WB°C	AIR Δ P Pa	L/S	EWT °C	LWT °C	WTR Δ P KPα																																																																																																
	22P2-H40L-MAU2-AH41	22P2B HPM L40	GAS/CHEM. ROOM	145000	700	2400	BACKWARD INCLINED	DIRECT	-	-	-	-	-	-	-	-	-	-	-	-	2.66	-	2624	35	31.64	19.0	18.9	-	72.8	12	20.6	-																																																																																																	
	22P2-H40L-MAU2-AH42	22P2B HPM L40	GAS/CHEM. ROOM	145000	700	2400	BACKWARD INCLINED	DIRECT	-	-	-	-	-	-	-	-	-	-	-	-	2.66	-	2624	35	31.64	19.0	18.9	-	72.8	12	20.6	-																																																																																																	
	22P2-H40L-MAU2-AH43	22P2B HPM L40	GAS/CHEM. ROOM	145000	700	2400	BACKWARD INCLINED	DIRECT	-	-	-	-	-	-	-	-	-	-	-	-	2.66	-	2624	35	31.64	19.0	18.9	-	72.8	12	20.6	-																																																																																																	
	22P2-H40E-MAU1-AH41	22P2A HPM L40	GAS/CHEM. ROOM	145000	700	2400	BACKWARD INCLINED	DIRECT	-	-	-	-	-	-	-	-	-	-	-	-	2.66	-	2624	35	31.64	19.0	18.9	-	72.8	12	20.6	-																																																																																																	
	22P2-H40E-MAU1-AH42	22P2A HPM L40	GAS/CHEM. ROOM	145000	700	2400	BACKWARD INCLINED	DIRECT	-	-	-	-	-	-	-	-	-	-	-	-	2.66	-	2624	35	31.64	19.0	18.9	-	72.8	12	20.6	-																																																																																																	
	22P2-H40E-MAU1-AH43	22P2A HPM L40	GAS/CHEM. ROOM	145000	700	2400	BACKWARD INCLINED	DIRECT	-	-	-	-	-	-	-	-	-	-	-	-	2.66	-	2624	35	31.64	19.0	18.9	-	72.8	12	20.6	-																																																																																																	
												20240604		20240604		20240604																																																																																																																	
MAKE-UP AIR HANDLING UNIT SCHEDULE																																																																																																																																	
B	C	D	E	F	G	H	I	J	PACKAGED AIR HANDLING UNIT SCHEDULE																																																																																																																								
									UNIT MARK	LOCATION	SERVICE	QTY	FAN				COOLING COIL								MOTOR				FILTER EFF. %				REMARKS																																																																																																
													TYPE	CMH	ESP(pa)	RPM	CAP.(KW)		EAT°C		WB	EWT °C	LWT °C	L/S	HP	POWER SOURCE	TYPE	PRE.	FINAL	HEPA @0.3um	STAGE 1	STAGE 1		STAGE 1																																																																																															
									-22P2-HB2E-PAH1-AH03	22P2A HPM LB2	FAB TO CUP 連通道	1	FORWARD CURVED	24000	-	-	237	154	29.0	20.7	5.0	13.3	6.9	7.5	3/460/60	-	35	-	MOTOR: IE4; 土直吹型																																																																																																				
									-22P2-HB2E-PAH1-AH04	22P2A HPM LB2	FAB TO CUP 連通道	1	FORWARD CURVED	24000	-	-	237	154	29.0	20.7	5.0	13.3	6.9	7.5	3/460/60	-	35	-	MOTOR: IE4; 土直吹型																																																																																																				
									-22P2-HB2E-PAH1-AH05	22P2A HPM LB2	FAB TO CUP 連通道	1	FORWARD CURVED	24000	-	-	237	154	29.0	20.7	5.0	13.3	6.9	7.5	3/460/60	-	35	-	MOTOR: IE4; 土直吹型																																																																																																				
									-22P2-HB2E-PAH1-AH06	22P2A HPM LB2	FAB TO CUP 連通道	1	FORWARD CURVED	24000	-	-	237	154	29.0	20.7	5.0	13.3	6.9	7.5	3/460/60	-	35	-	MOTOR: IE4; 土直吹型																																																																																																				
-22P2-HB2L-PAH2-AH03	22P2B HPM LB2	FAB TO CUP 連通道	1	FORWARD CURVED	24000	-	-	237	154	29.0	20.7	5.0	13.3	6.9	7.5	3/460/60	-	35	-	MOTOR: IE4; 土直吹型																																																																																																													
-22P2-HB2L-PAH2-AH04	22P2B HPM LB2	FAB TO CUP 連通道	1	FORWARD CURVED	24000	-	-	237	154	29.0	20.7	5.0	13.3	6.9	7.5	3/460/60	-	35	-	MOTOR: IE4; 土直吹型																																																																																																													
-22P2-HB1E-PAH1-AH07	22P2A HPM LB1	水課排空區/控制室	1	FORWARD CURVED	11000	250	-	108	70	29.0	20.7	5.0	13.3	3.1	5	3/460/60	-	35	-	MOTOR: IE4																																																																																																													
-22P2-HB1E-PAH1-AH08	22P2A HPM LB1	水課排空區/控制室	1	FORWARD CURVED	11000	250	-	108	70	29.0	20.7	5.0	13.3	3.1	5	3/460/60	-	35	-	MOTOR: IE4																																																																																																													
-22P2-HB1E-PAH1-AH09	22P2A HPM LB1	水課排空區/控制室	1	FORWARD CURVED	6000	250	-	56	37	29.0	20.7	5.0	13.3	1.62	3	3/460/60	-	35	-	MOTOR: IE4																																																																																																													
-22P2-HB1E-PAH1-AH10	22P2A HPM LB1	水課排空區/控制室	1	FORWARD CURVED	6000	250	-	56	37	29.0	20.7	5.0	13.3	1.62	3	3/460/60	-	35	-	MOTOR: IE4																																																																																																													
-22P2-HB1E-PAH1-AH11	22P2A HPM LB1	水課排空區/控制室	1	FORWARD CURVED	6000	250	-	56	37	29.0	20.7	5.0	13.3	1.62	3	3/460/60	-	35	-	MOTOR: IE4																																																																																																													
-22P2-HB1E-PAH1-AH12	22P2A HPM LB1	水課排空區/控制室	1	FORWARD CURVED	6000	250	-	56	37	29.0	20.7	5.0	13.3	1.62	3	3/460/60	-	35	-	MOTOR: IE4																																																																																																													
22P2-HB2E-PAH1-AH13	22P2B HPM LB2	B/O電氣室	1	FORWARD CURVED	6000	250	-	56	37	29.0	20.7	5.0	13.3	1.62	3	3/460/60	-	35	-	MOTOR: IE4; 含風管型偵煙探測器																																																																																																													
22P2-HB2E-PAH1-AH14	22P2B HPM LB2	B/O電氣室	1	FORWARD CURVED	6000	250	-	56	37	29.0	20.7	5.0	13.3	1.62	3	3/460/60	-	35	-	MOTOR: IE4; 含風管型偵煙探測器																																																																																																													
22P2-HB1L-PAH2-AH07	22P2B HPM LB1	水課排空區/控制室	1	FORWARD CURVED	13800	250	-	136	87	29.0	20.7	5.0	13.3	3.9	7.5	3/460/60	-	35	-	MOTOR: IE4	20240725,tsmc 要求一般版走通,機房增加偵煙探測器																																																																																																												
22P2-HB1L-PAH2-AH08	22P2B HPM LB1	水課排空區/控制室	1	FORWARD CURVED	13800	250	-	136	87	29.0	20.7	5.0	13.3	3.9	7.5	3/460/60	-	35	-	MOTOR: IE4																																																																																																													
22P2-H40E-PAH1-AH20	22P2A HPM L40	AAS ELECTRICAL ROOM	1	FORWARD CURVED	20100	250	-	199	129	29.0	20.7	5.0	13.3	5.85	10	3/460/60	-	35	-	MOTOR: IE4																																																																																																													
22P2-H40E-PAH1-AH21	22P2A HPM L40	AAS ELECTRICAL ROOM	1	FORWARD CURVED	20100	250	-	199	129	29.0	20.7	5.0	13.3	5.85	10	3/460/60	-	35	-	MOTOR: IE4																																																																																																													
22P2-H40E-PAH1-AH22	22P2A HPM L40	AAS ELECTRICAL ROOM	1	FORWARD CURVED	20100	250	-	199	129	29.0	20.7	5.0	13.3	5.85	10	3/460/60	-	35	-	MOTOR: IE4 (FUTURE)																																																																																																													
22P2-H40E-PAH1-AH23	22P2A HPM L40	AAS ELECTRICAL ROOM	1	FORWARD CURVED	20100	250	-	199	129	29.0	20.7	5.0	13.3	5.85	10	3/460/60	-	35	-	MOTOR: IE4																																																																																																													
22P2-H40E-PAH1-AH24	22P2A HPM L40	AAS ELECTRICAL ROOM	1	FORWARD CURVED	20100	250	-	199	129	29.0	20.7	5.0	13.3	5.85	10	3/460/60	-	35	-	MOTOR: IE4																																																																																																													
22P2-H40L-PAH2-AH20	22P2B HPM L40	AAS ELECTRICAL ROOM	1	FORWARD CURVED	20100	250	-	199	129	29.0	20.7	5.0	13.3	5.85	10	3/460/60	-	35	-	MOTOR: IE4																																																																																																													
22P2-H40L-PAH2-AH21	22P2B HPM L40	AAS ELECTRICAL ROOM	1	FORWARD CURVED	20100	250	-	199	129	29.0	20.7	5.0	13.3	5.85	10	3/460/60	-	35	-	MOTOR: IE4																																																																																																													
22P2-H40L-PAH2-AH22	22P2B HPM L40	AAS ELECTRICAL ROOM	1	FORWARD CURVED	20100	250	-	199	129	29.0	20.7	5.0	13.3	5.85	10	3/460/60	-	35	-	MOTOR: IE4																																																																																																													
22P2-H40L-PAH2-AH23	22P2B HPM L40	AAS ELECTRICAL ROOM	1	FORWARD CURVED	20100	250	-	199	129	29.0	20.7	5.0	13.3	5.85	10	3/460/60	-	35	-	MOTOR: IE4 (FUTURE)																																																																																																													
22P2-H40L-PAH2-AH24	22P2B HPM L40	AAS ELECTRICAL ROOM	1	FORWARD CURVED	20100	250	-	199	129	29.0	20.7	5.0	13.3	5.85	10	3/460/60	-	35	-	MOTOR: IE4																																																																																																													
22P2-H40L-PAH2-AH25	22P2B HPM L40	AAS ELECTRICAL ROOM	1	FORWARD CURVED	20100	250	-	199	129	29.0	20.7	5.0	13.3	5.85	10	3/460/60	-	35	-	MOTOR: IE4																																																																																																													
22P2-HR1E-PAH1-AH31	22P2A HPM LR1	THC ROOM	1	FORWARD CURVED	20100	250	-	199	129	29.0	20.7	5.0	13.3	5.85	10	3/460/60	-	35	-	MOTOR: IE4																																																																																																													
22P2-HR1E-PAH1-AH32	22P2A HPM LR1	THC ROOM	1	FORWARD CURVED	20100	250	-	199	129	29.0	20.7	5.0	13.3	5.85	10	3/460/60	-	35	-	MOTOR: IE4																																																																																																													
ELECTRICAL/UPS ROOM PACKAGED AIR HANDLING UNIT SCHEDULE																																																																																																																																	
I	J	K	L	M	N	O	P	Q	R	S	T	U	V	W	X	Y	Z	AA	AB	AC	AD	AE	AF	AG	AH	AI	AJ	AK	AL	AM	AN	AO	AP	AQ	AR	AS	AT	AU	AV	AW	AX	AY	AZ	BA	BB	BC	BD	BE	BF	BG	BH	BI	BJ	BK	BL	BM	BN	BO	BP	BQ	BR	BS	BT	BU	BV	BW	BX	BY	BZ	CA	CB	CC	CD	CE	CF	CG	CH	CI	CJ	CK	CL	CM	CN	CO	CP	CQ	CR	CS	CT	CU	CV	CW	CX	CY	CZ	DA	DB	DC	DD	DE	DF	DG	DH	DI	DJ	DK	DL	DM	DN	DO	DP	DQ	DR	DS	DT	DU	DV	DW	DX	DY	DZ	EA	EB	EC	ED	EE	EF	EG	EH

1	2	3	4	5	6	7	8	9	10	11	12	13	14										
A	FAN COIL UNIT SCHEDULE																						
	UNIT MARK	QTY	AIR FLOW CMH	ESP(pa)	COOLING COIL								HEATING COIL			MOTOR		REMARKS					
					TOTAL KW	SENSIBLE KW	EAT °C		LAT °C		L/S	EWT °C	LWT °C	CAP. KW	EAT °C DB	L/S	EWT °C		LWT °C	WATTS	POWER SOURCE	TYPE	
	④	-	684	50	4.33	2.63	25	20	-	-	0.21	5	10	-	-	-	-	-	95	1/208/60	-	吊掛隱藏式小型送風機 (附溫度控制器及控制面板)	CEILING RECESSED TYPE W/R.A. BOX & FILTER
	⑥	20241025	2	1044	50	5.76	3.54	25	20	-	-	0.28	5	10	-	-	-	-	142	1/208/60	-	吊掛隱藏式小型送風機 (附溫度控制器及控制面板)	CEILING RECESSED TYPE W/R.A. BOX & FILTER
	⑧	2	1332	50	8.01	4.83	25	20	-	-	0.39	5	10	-	-	-	-	-	166	1/208/60	-	吊掛隱藏式小型送風機 (附溫度控制器及控制面板)	CEILING RECESSED TYPE W/R.A. BOX & FILTER
	⑩	-	1728	50	9.58	5.87	25	20	-	-	0.46	5	10	-	-	-	-	-	228	1/208/60	-	吊掛隱藏式小型送風機 (附溫度控制器及控制面板)	CEILING RECESSED TYPE W/R.A. BOX & FILTER
	⑫	-	2052	50	10.92	6.82	25	20	-	-	0.53	5	10	-	-	-	-	-	285	1/208/60	-	吊掛隱藏式小型送風機 (附溫度控制器及控制面板)	CEILING RECESSED TYPE W/R.A. BOX & FILTER
	△	2	684	50	4.33	2.63	25	20	-	-	0.21	5	10	-	-	-	-	-	95	1/208/60	-	吊掛露明式小型送風機 (附溫度控制器及控制面板)	
	△	-	1044	50	5.76	3.54	25	20	-	-	0.28	5	10	-	-	-	-	-	142	1/208/60	-	吊掛露明式小型送風機 (附溫度控制器及控制面板)	
B	△	14	1332	50	8.01	4.83	25	20	-	-	0.39	5	10	-	-	-	-	-	166	1/208/60	-	吊掛露明式小型送風機 (附溫度控制器及控制面板)	
	△	-	1728	50	9.58	5.87	25	20	-	-	0.46	5	10	-	-	-	-	-	228	1/208/60	-	吊掛露明式小型送風機 (附溫度控制器及控制面板)	
	△	4	2052	50	10.92	6.82	25	20	-	-	0.53	5	10	-	-	-	-	-	285	1/208/60	-	吊掛露明式小型送風機 (附溫度控制器及控制面板)	
	⑫	2	2052	50	10.92	6.82	25	-	-	-	0.53	5	10	10.92	18	0.53	35	30	285	1/120/60	-	吊掛露明式小型送風機 (附溫度控制器及控制面板)	比例式控制 (HPM L10 A■ ST-250)
C	EXHAUST FAN SCHEDULE																						
	UNIT MARK	LOCATION	SERVICE	QTY	FAN						MOTOR			REMARKS									
					TYPE	CMH	ESP(pa)	WHEEL TYPE	RPM	DRIVE	BHP	KW	POWER SOURCE		TYPE								
	22P2-HB2L-EF2-F01	22P2B HPM LB2	WWT	1	SINGLE INLET CENTRIFUGAL FAN	45000	650	BACKWARD INCLINED	-	BELT	-	15	3/460/60	-	MOTOR: IE 4; 落地型								
	22P2-HB2L-EF2-F02	22P2B HPM LB2	WWT	1	SINGLE INLET CENTRIFUGAL FAN	45000	650	BACKWARD INCLINED	-	BELT	-	15	3/460/60	-	MOTOR: IE 4; 落地型								
	22P2-H40L-EF2-F03	22P2B HPM L40	電梯機房	1	WALL MOUNTED	2300	62.5	PROPELLER	-	DIRECT	-	0.2	1/208/60	-									
	22P2-HB2E-EF1-F01	22P2A HPM LB2	WWT	1	SINGLE INLET CENTRIFUGAL FAN	45000	650	BACKWARD INCLINED	-	BELT	-	15	3/460/60	-	MOTOR: IE 4; 落地型								
	22P2-HB2E-EF1-F02	22P2A HPM LB2	WWT	1	SINGLE INLET CENTRIFUGAL FAN	45000	650	BACKWARD INCLINED	-	BELT	-	15	3/460/60	-	MOTOR: IE 4; 落地型								
	22P2-H40E-EF1-F03	22P2A HPM L40	電梯機房	1	WALL MOUNTED	2300	62.5	PROPELLER	-	DIRECT	-	0.2	1/208/60	-									
	22P2-HR1E-EF1-F04	22P2A HPM LR1	廁所/茶水間	1	INLINE FAN	25000	600	BACKWARD INCLINED	-	BELT	-	7.5	3/460/60	-	MOTOR: IE 4; 屋外落地型								
	22P2-HR1E-EF1-F06	22P2A HPM LR1	電梯機房	1	WALL MOUNTED	2300	62.5	PROPELLER	-	DIRECT	-	0.2	1/208/60	-									
	22P2-HR1E-EF1-F07	22P2A HPM LR1	電梯機房	1	WALL MOUNTED	2300	62.5	PROPELLER	-	DIRECT	-	0.2	1/208/60	-									
	22P2-HR2E-EF1-F08	22P2A HPM LR2	電梯機房	1	WALL MOUNTED	2300	62.5	PROPELLER	-	DIRECT	-	0.2	1/208/60	-									
	22P2-HB1E-EF1-F09	22P2B HPM LB2	廁所/茶水間	1	INLINE FAN	8100	250	FORWARD CURVED	-	BELT	-	2.2	3/460/60	-	MOTOR: IE 4; 室內吊掛型 20240725 翻修 AB B1 廁所排風扇								
	22P2-HB2L-EF2-F03	22P2B HPM LB2	WWT	1	SINGLE INLET CENTRIFUGAL FAN	45000	650	BACKWARD INCLINED	-	BELT	-	15	3/460/60	-	MOTOR: IE 4; 落地型								
	22P2-HB2L-EF2-F04	22P2B HPM LB2	WWT	1	SINGLE INLET CENTRIFUGAL FAN	45000	650	BACKWARD INCLINED	-	BELT	-	15	3/460/60	-	MOTOR: IE 4; 落地型 20240725 FAB B2 區機調整追加排風扇								
D	EXHAUST FAN SCHEDULE (透浦型風機)																						
	UNIT MARK	LOCATION	SERVICE	QTY	FAN						MOTOR			REMARKS									
					TYPE	CMH	ESP(mmAq)	WHEEL TYPE	RPM	DRIVE	BHP	KW	POWER SOURCE		TYPE								
	22P2-HR2E-EF1-F09	22P2A HPM LR2	LB2 (化糞池)	1	透浦型風機	700	485(48.5)	-	-	DIRECT	-	3.75(2P)	3/460/60	-	MOTOR: IE 4; 屋外落地型								
	22P2-HR2E-EF1-F10	22P2A HPM LR2	LB2 (化糞池)	1	透浦型風機	700	485(48.5)	-	-	DIRECT	-	3.75(2P)	3/460/60	-	MOTOR: IE 4; 屋外落地型 (STANDBY)								
E	CO2 EXHAUST FAN SCHEDULE																						
	UNIT MARK	LOCATION	SERVICE	CMH	FAN			MOTOR						REMARKS									
					TYPE	ESP Pa	FRPM	WHEEL TYPE	DRIVE	BHP	POWER (KW)	VOLTAGE	TYPE										
	22P2-H40L-CEX2-F01	22P2B HPM L40	ELECTRICAL ROOM	31000	INLINE FAN	500	-	BACKWARD INCLINED	BELT	-	11	3/460/60	ODP	室內吊掛型									
	22P2-H40E-CEX1-F01	22P2A HPM L40	ELECTRICAL ROOM	31000	INLINE FAN	500	-	BACKWARD INCLINED	BELT	-	11	3/460/60	ODP	室內吊掛型									
	22P2-HR1E-CEX1-F02	22P2A HPM LR1	VOC PANEL ROOM	6000	INLINE FAN	250	-	FORWARD CURVED	BELT	-	1.5	3/460/60	ODP	室內吊掛型									
	20240111 配合警電站設備調整																						
G	AIR CURTAIN SCHEDULE																						
	UNIT MARK	LOCATION	SERVICE	QTY	FAN		SIZE		MOTOR			REMARKS											
					有效遮斷距離 (m)	CMM	W (mm)	H (mm)	W	POWER SOURCE	TYPE												
	22P2-H10E-SF1-F01,02	22P2A HPM L10	HPM 隔噪區	2	4.0	53	1200	265	345	1/220/60	-												
	22P2-H10E-SF1-F03,04,05,06	22P2A HPM L10	HPM 隔噪區	4	4.0	53	1200	265	345	1/220/60	-												
	22P2-H10L-SF2-F01,02	22P2A HPM L10	HPM 隔噪區	2	4.0	53	1200	265	345	1/220/60	-												
	22P2-H10L-SF2-F03,04,05,06	22P2A HPM L10	HPM 隔噪區	4	4.0	53	1200	265	345	1/220/60	-												
	20241210																						
I																							
J																							
1	2	3	4	5	6	7	8	9	10	11	12	13	14										

①

②

③

④

A

B

G

H

⑤

⑥

⑦

⑧

C

D

J

K

⑨

⑩

⑪

⑫

E

F

I

L

⑬

⑭

⑮

⑯

P

Q

R

S

Building Code

A: Office

F: FAB

H: HPM

C: CUP

G: Gas Yard & BSGS

S: Supporting

N: ASC

W: Warehouse

North Arrow

↑

North

REV

DATE

修正者

修正

CONTRACTOR

uis

漢唐集成股份有限公司

United Integrated Service

DRAWN

ROGER YEH

DATE

2024/12/10

RECHECKED

Steven Yu

DATE

2024/12/10

DESIGNED

ROGER YEH

DATE

2024/12/10

APPROVED

JOSEPH LEE

DATE

2024/12/10

TITLE

MECHANICAL SYSTEM EQUIPMENT SCHEDULE (7) HPM

PROJECT

FAB22 Phase 2 PROJECT

PACKAGE NAME

MEP SYSTEM

DRAWING NAME

F22P2-M-1-H-02

SCALE

NOT TO SCALE

UNIT

mm

FILE NAME


F22P2-M-1-H-02

Rev

Serial number: 202503251031-15148411

出圖日期: 2024/12/10



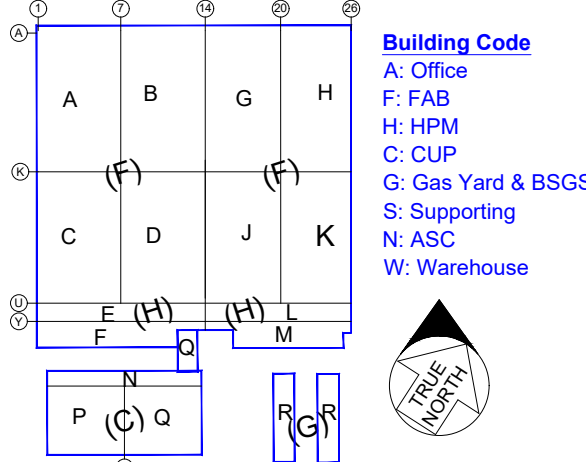


台灣積體電路製造股份有限公司
Taiwan Semiconductor Manufacturing Company, Ltd.

CONTRACTOR

uis 漢唐集成股份有限公司
United Integrated Service

FLOW DIAGRAM-

PIPING SYSTEM (8) -	
PROJECT	FAB22 Phase 2 PROJECT
PACKAGE NAME	MEP SYSTEM
DRAWING NAME	F22P2-M-2-C-08
SCALE	UNIT
NOT TO SCALE	mm
FILE NAME	Rev.
F22P2-M-2-C-07	

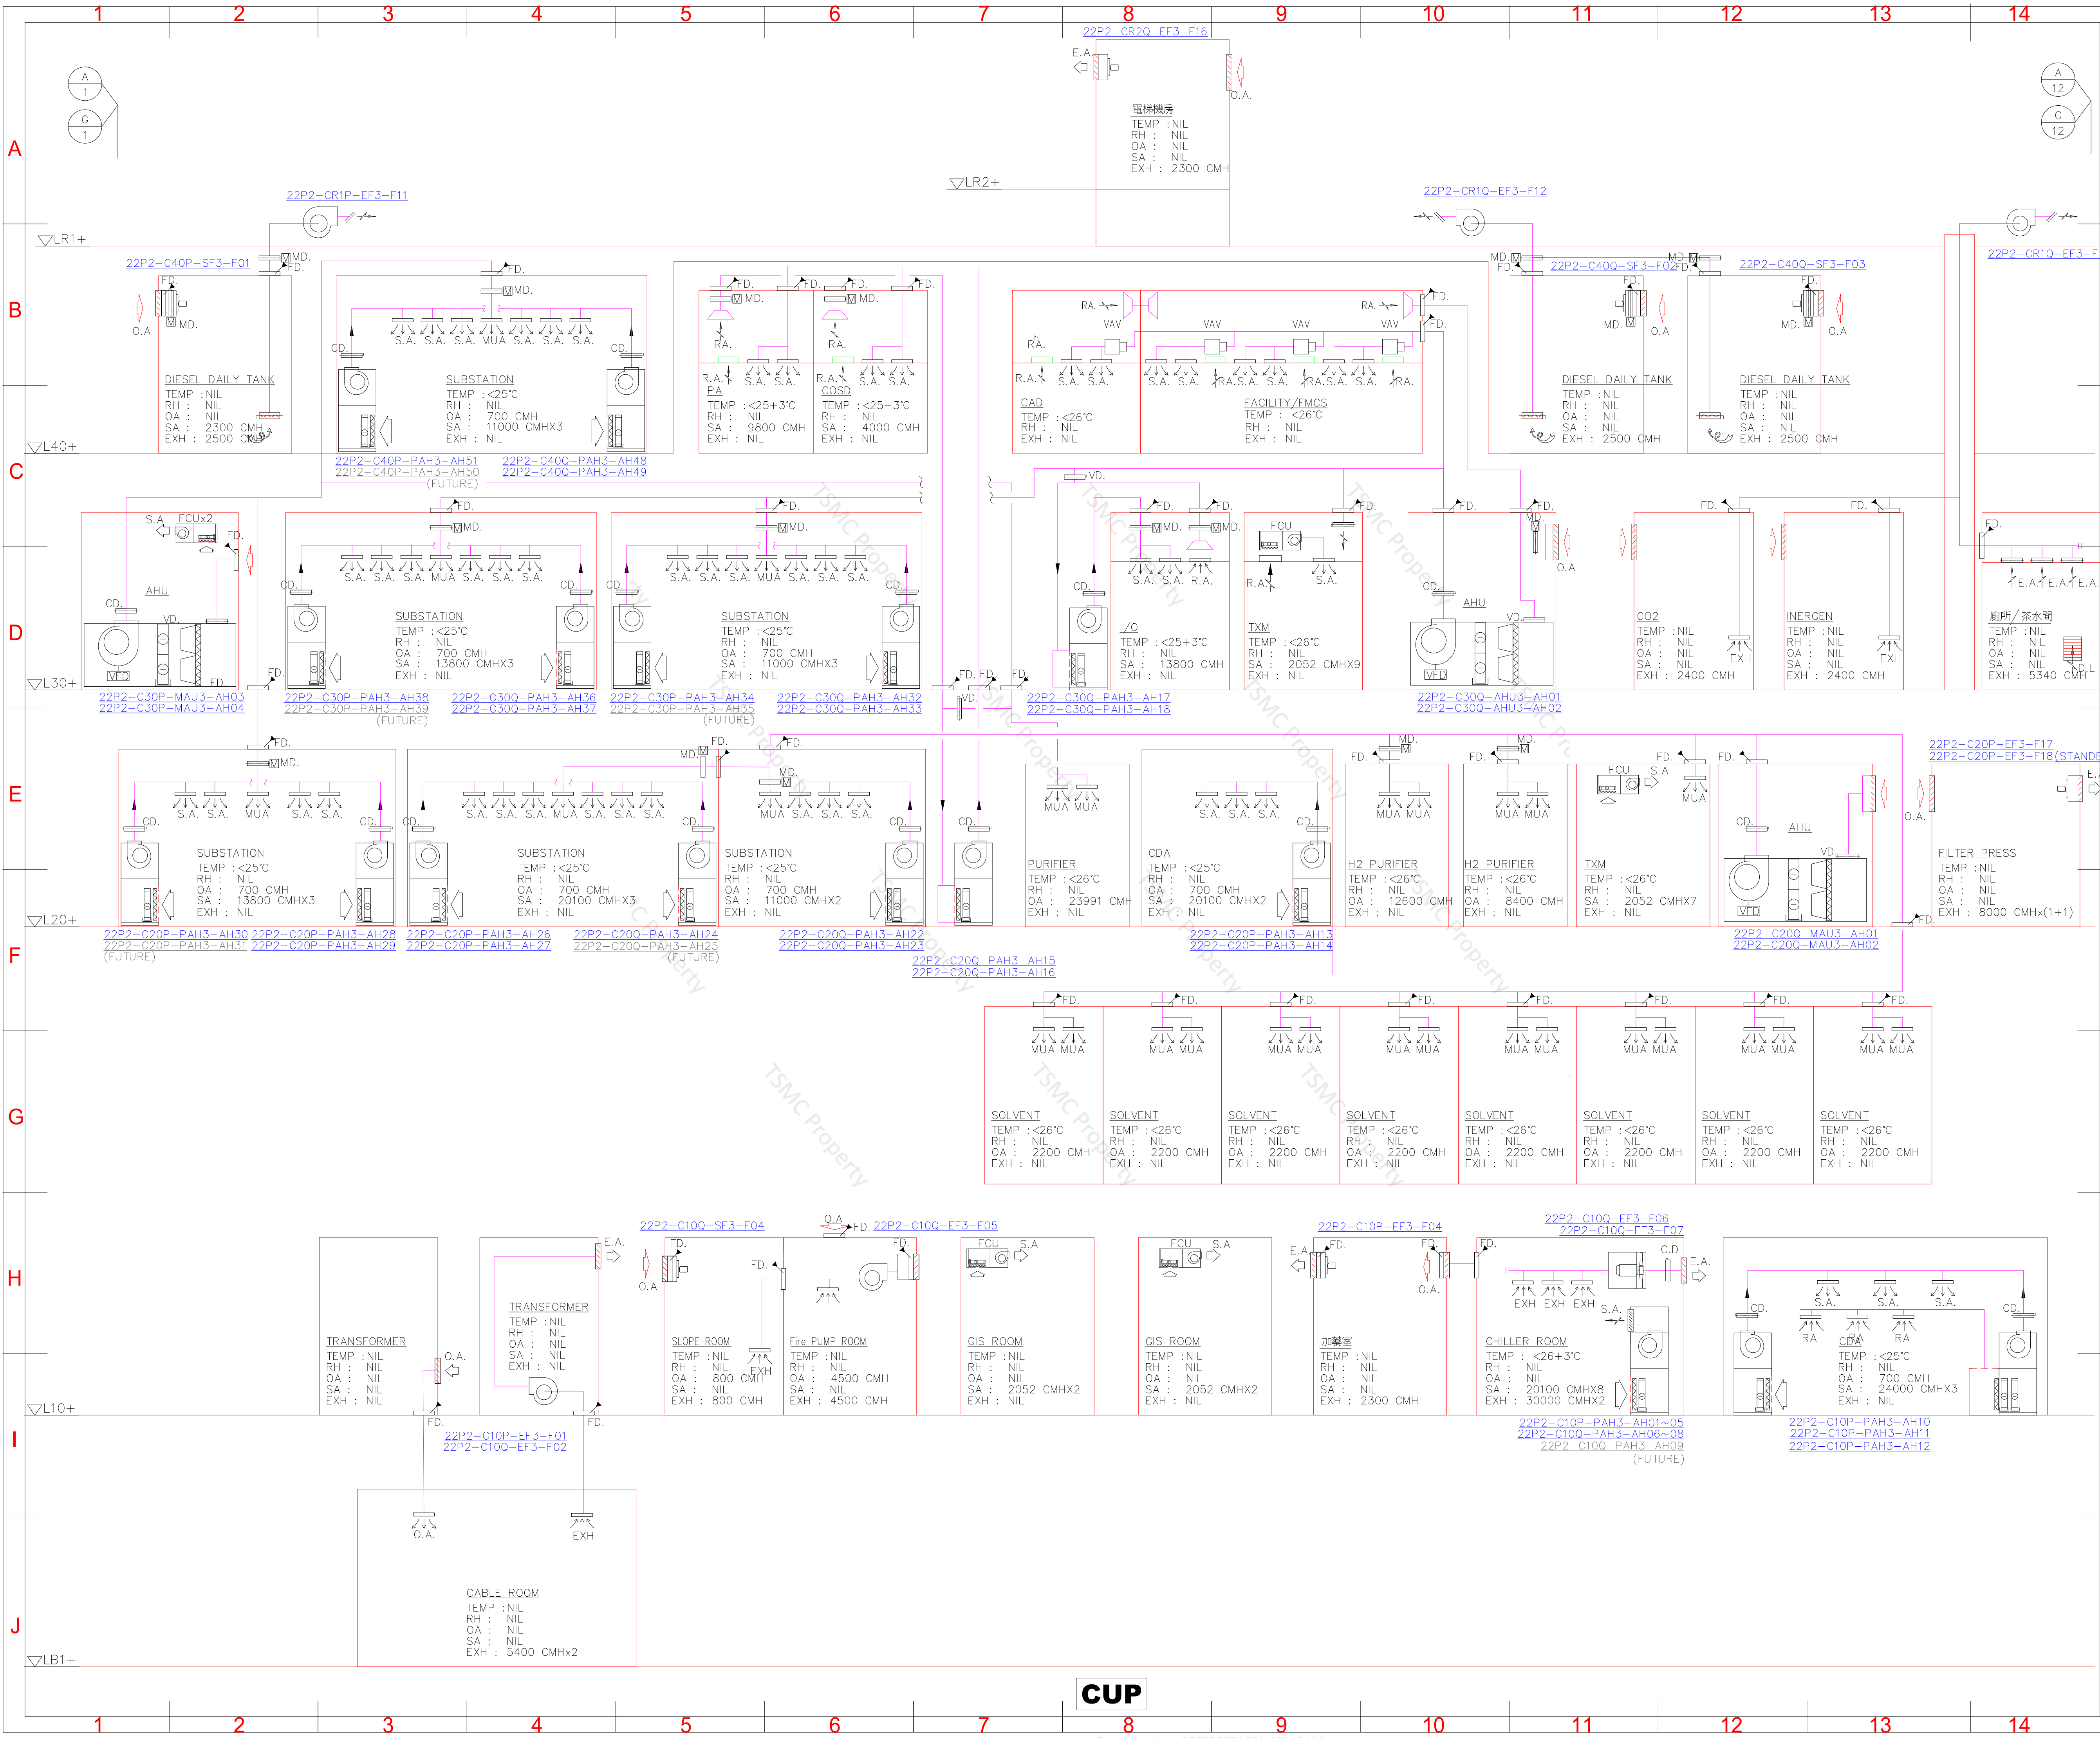

KEY PLAN

Building Code

- A: Office
- F: FAB
- H: HPM
- C: CUP
- G: Gas Yard & BSGS
- S: Supporting
- N: ASC
- W: Warehouse

版次	日期	修正者	修正
VER.	DATE	REVIEW	REVISION

台積電

台灣積體電路製造股份有限公司

Taiwan Semiconductor Manufacturing Company, Ltd.

ACCEPTANCE REVIEWED	DATE	ACCEPTANCE REVIEWED	DATE



CONTRACTOR

uis 漢唐集成股份有限公司

United Integrated Service

DRAWN	ROGER YEH	DATE	2024/12/11	RECHECKED	Steven Yu	DATE	2024/12/11
DESIGNED	ROGER YEH	DATE	2024/12/11	APPROVED	JOSEPH LEE	DATE	2024/12/11
TITLE							
FLOW DIAGRAM- DUCTING SYSTEM (1) CUP							
PROJECT							
FAB22 Phase 2 PROJECT							
PACKAGE NAME							
MEP SYSTEM							
DRAWING NAME							
F22P2-M-2-C-09							
SCALE							
NOT TO SCALE							
FILE NAME							
F22P2-M-2-C-09							
UNIT							
mm							
Rev							

出圖日期: 2024/12/11

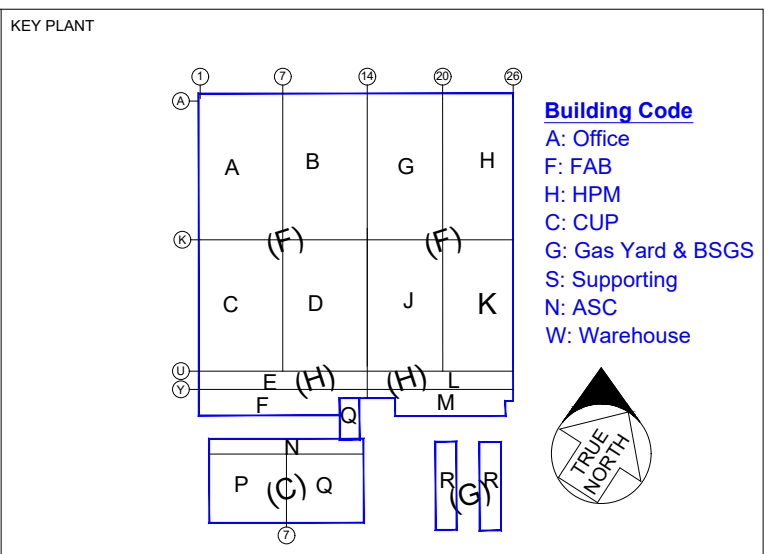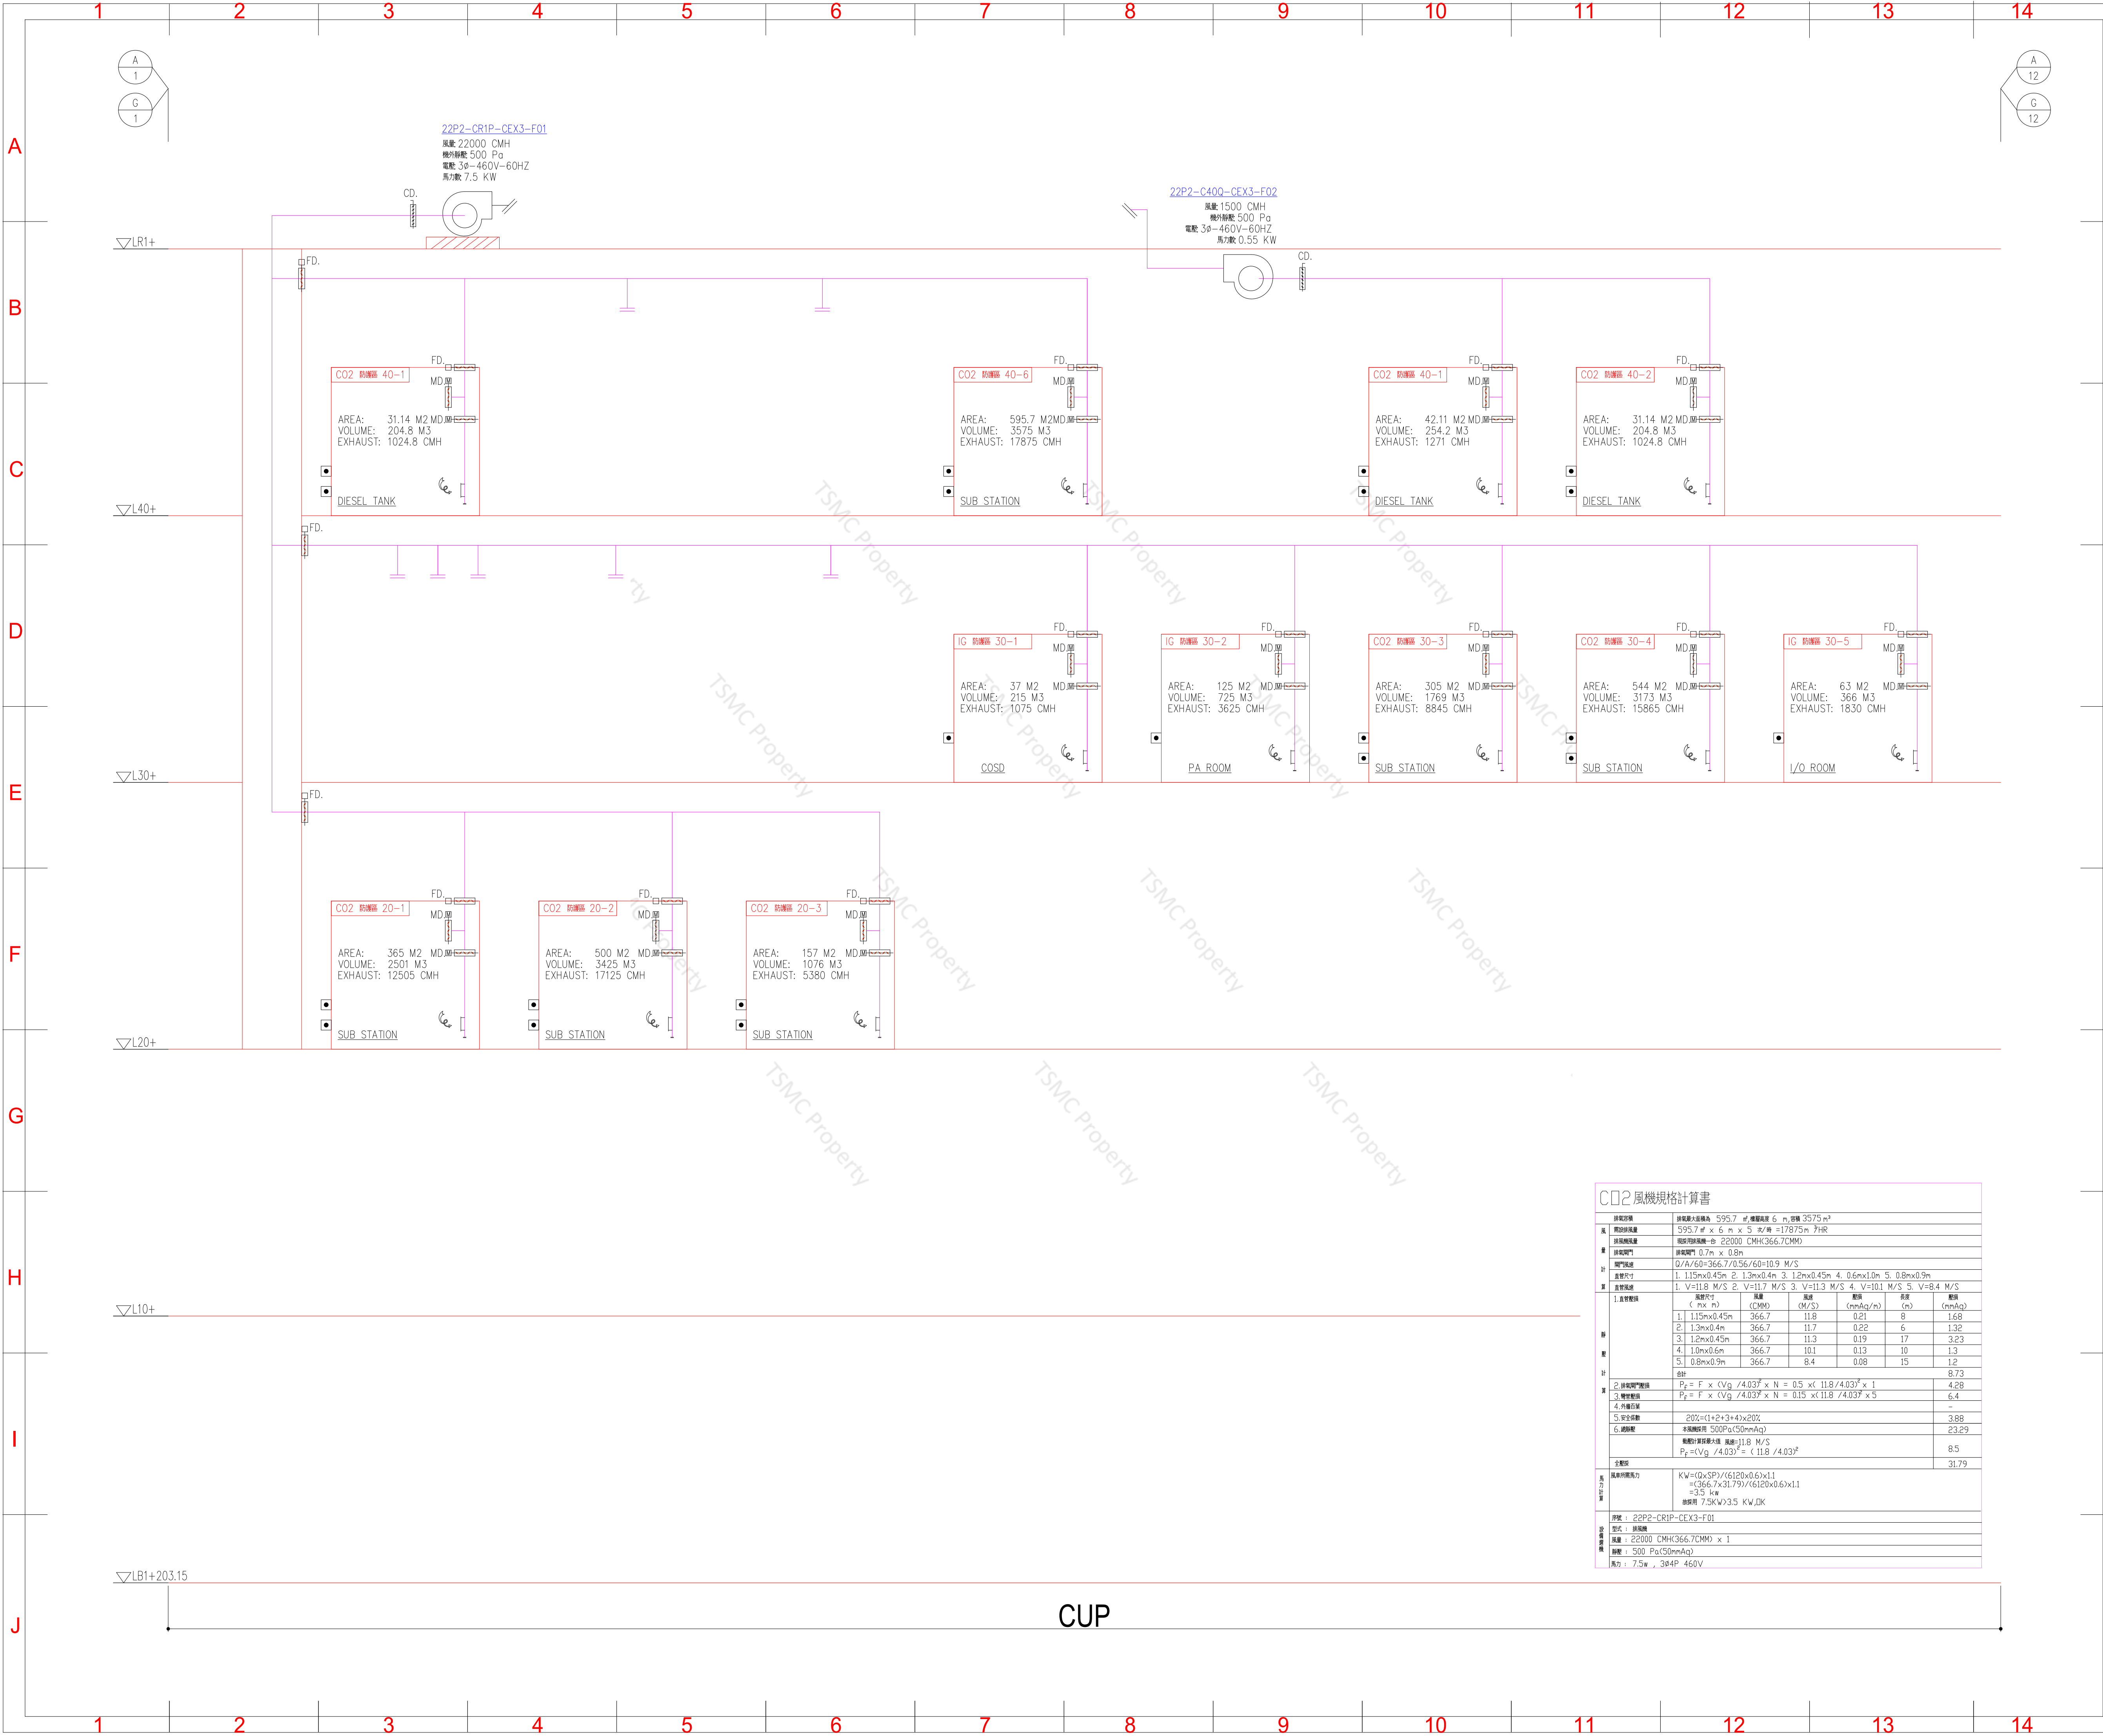

CO2 風機規格計算書

排氣設備	排氣量大面積為 595.7 m ² , 總體積為 6 m ³ , 容積 3575 m ³
排氣設備	595.7 m ² x 6 m x 5 m/年 = 17875 m ³ /年
排氣設備	排氣設備總量 = 22000 CMH(366.7CMH)
排氣設備	排氣設備 0.7m x 0.8m
排氣設備	0.7m/60-366.7/60=10.9 M/S
直徑尺寸	1. 115m x 0.45m 2. 13m x 0.4m 3. 12m x 0.45m 4. 0.6m x 1.0m 5. 0.8m x 0.9m
直徑尺寸	1. V=11.8 M/S 2. V=11.7 M/S 3. V=11.3 M/S 4. V=10.1 M/S 5. V=8.4 M/S
1. 直徑尺寸	面積尺寸 (m ² , m ³) 風量 (CMH) 風速 (m/s) 面積 (m ²) 面積 (m ²)
1.	115m x 0.45m 366.7 11.7 0.21 8 1.68
2.	13m x 0.4m 366.7 11.7 0.22 6 1.32
3.	12m x 0.45m 366.7 11.3 0.19 17 3.23
4.	0.6m x 1.0m 366.7 10.1 0.13 10 1.3
5.	0.8m x 0.9m 366.7 8.4 0.08 15 1.2
合計	8.73
2. 排氣設備面積	P ₂ = F x (Vg / 4.037 x N = 0.5 x 11.8 / 4.037 x 1
3. 排氣設備面積	P ₂ = F x (Vg / 4.037 x N = 0.15 x 11.8 / 4.037 x 5
4. 排氣設備	-
5. 安全面積	20% = (1 + 2 + 3 + 4) x 20%
6. 總面積	總面積 = 500 Pa(50m ²)
安全面積	P ₂ = (Vg / 4.037) x N = 11.8 / 4.037
安全面積	31.79
風車所需馬力	KW = (Q x 3P) / (6120 x 0.6) x 1.1
風車所需馬力	= 35 KW
風車所需馬力	所需馬力 7.5KW/3.5 KW/DK
排氣設備	排氣 : 22P2-CR1P-CEX3-F01
排氣設備	排氣 : 排氣
排氣設備	風量 : 22000 CMH(366.7CMH) x 1
排氣設備	風速 : 500 Pa(50m ²)
排氣設備	馬力 : 7.5W , 3.04P 4.60V

版本	日期	修正者	修正
VER.	DATE	REVIEW	REVISION

台灣積體電路製造股份有限公司
Taiwan Semiconductor Manufacturing Company, Ltd.

ACCEPTANCE REVIEWED	DATE	ACCEPTANCE REVIEWED	DATE
---------------------	------	---------------------	------

CONTRACTOR

UIS 漢唐集成股份有限公司
United Integrated Service

DRAWN	ROGER YEH	DATE	2024/12/11	RECHECKED	Steven Yu	DATE	2024/12/11
DESIGNED	ROGER YEH	DATE	2024/12/11	APPROVED	JOSEPH LEE	DATE	2024/12/11

TITLE


**FLOW DIAGRAM-
CO2 EXHAUST SYSTEM
(1)
CUP**


PROJECT	FAB22 Phase 2 PROJECT
PACKAGE NAME	MEP SYSTEM
DRAWING NAME	F22P2-M-2-C-10
SCALE	NOT TO SCALE
FILE NAME	F22P2-M-2-C-10

UNIT
mm

Rev

出圖日期: 2024/12/11

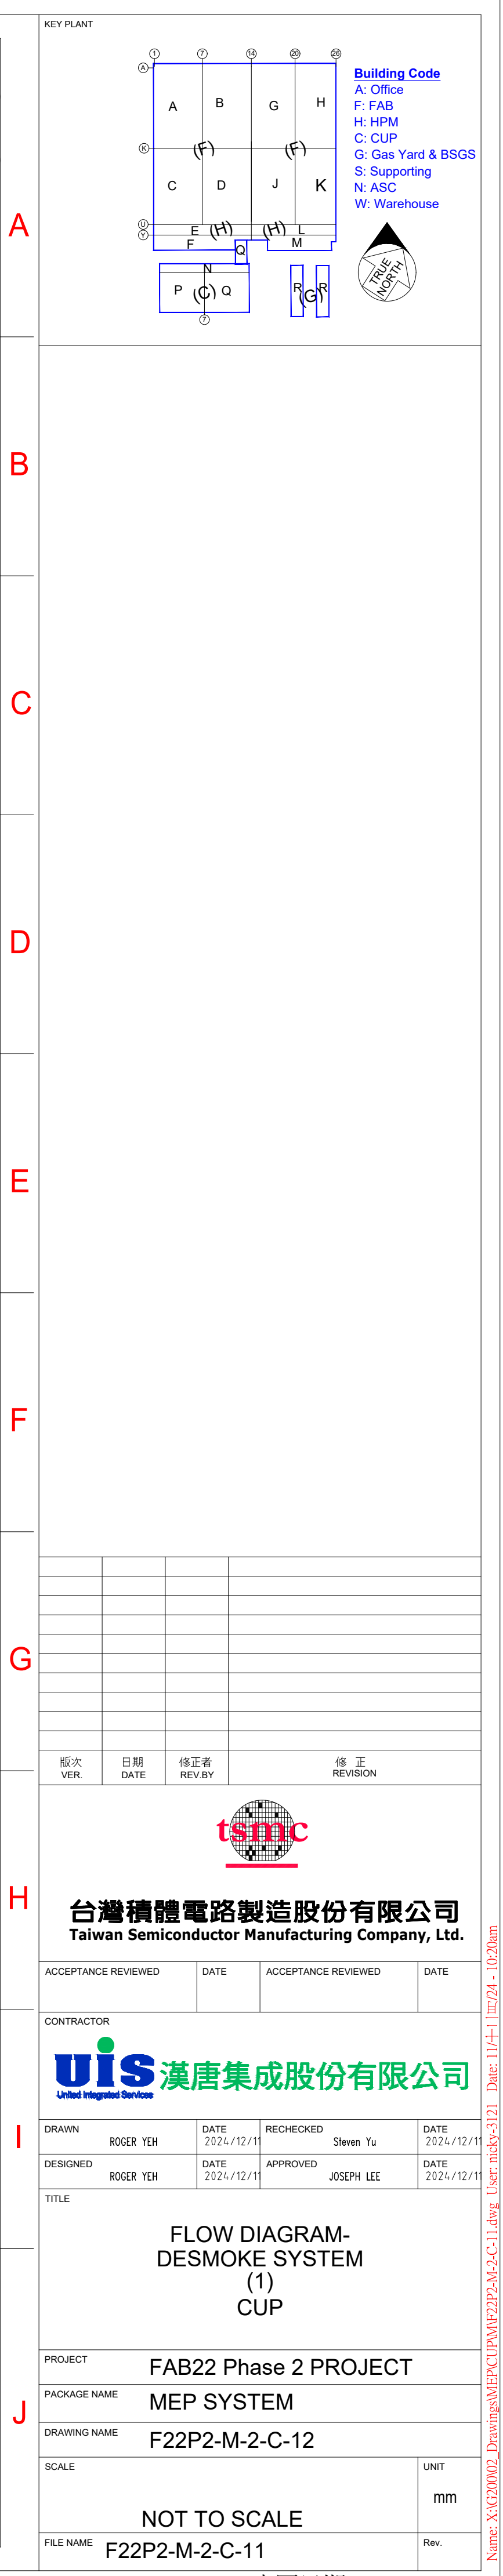

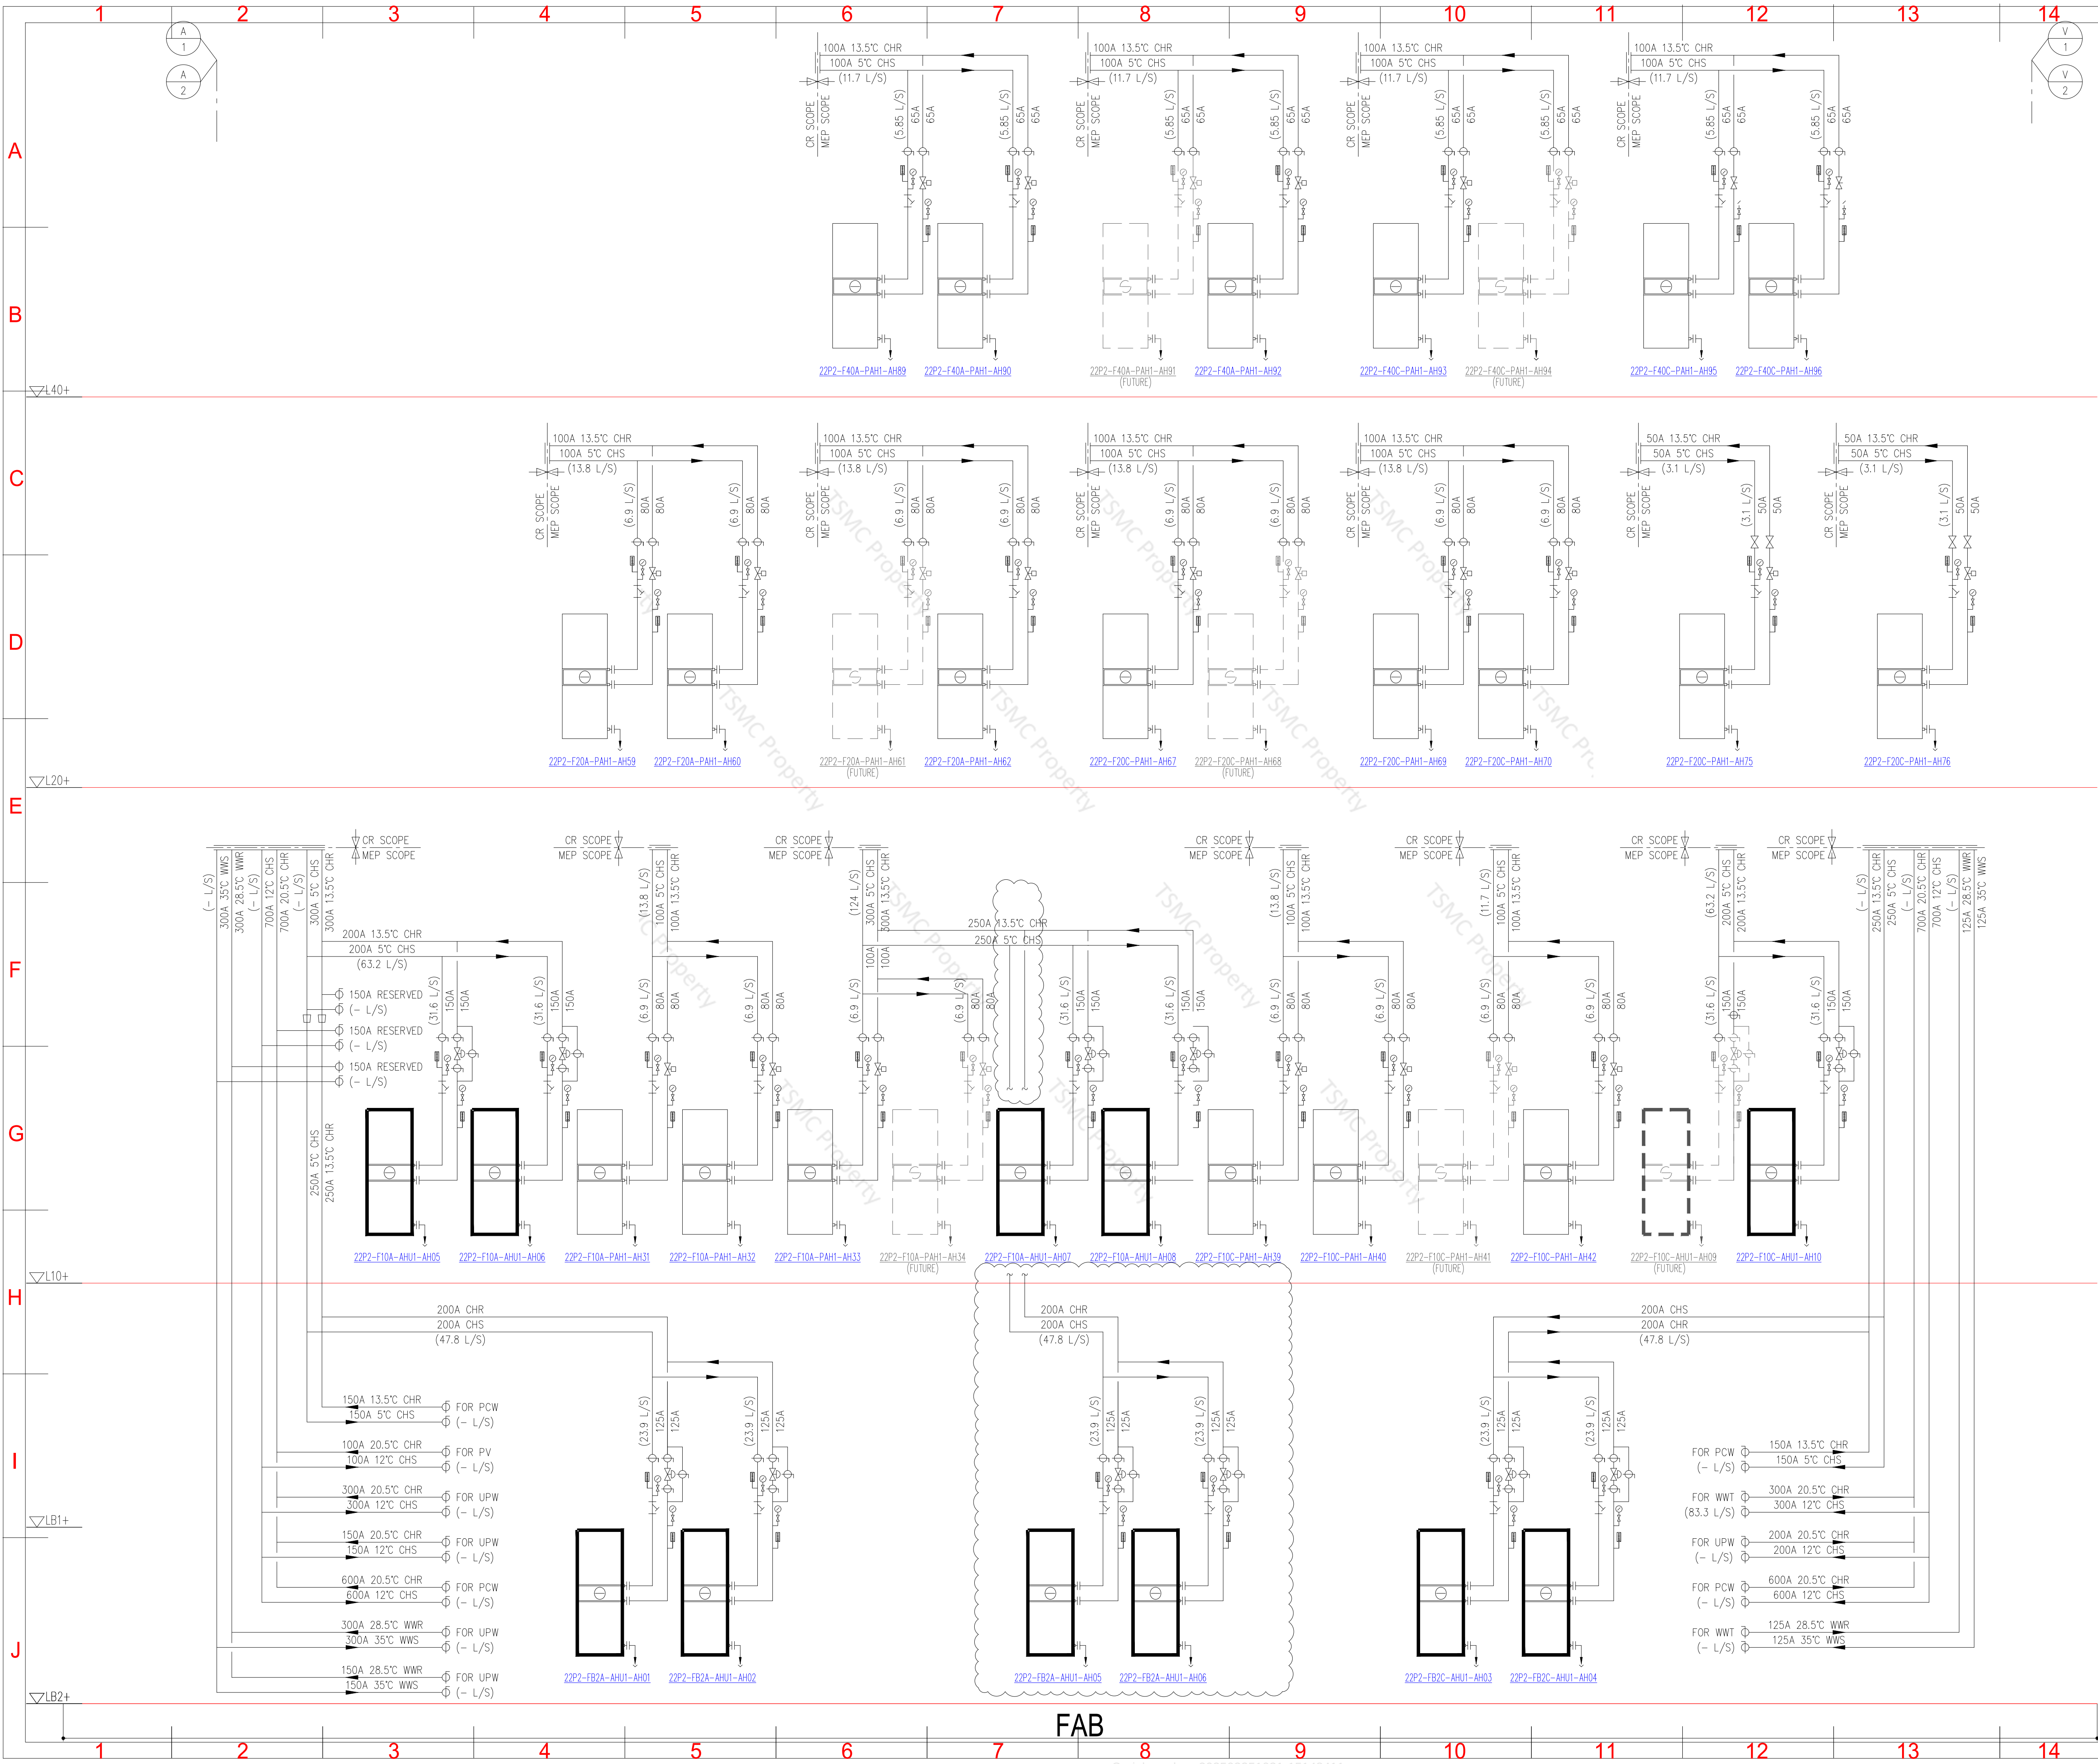

KEY PLANT

Building Code

- A: Office
- F: FAB
- H: HPM
- C: CUP
- G: Gas Yard & BSGS
- N: Supporting
- W: Warehouse

版次	日期	修正者	修正
VER.	DATE	REVIEW	REVISION

台灣積體電路製造股份有限公司
Taiwan Semiconductor Manufacturing Company, Ltd.

ACCEPTANCE REVIEWED	DATE	ACCEPTANCE REVIEWED	DATE

CONTRACTOR

漢唐集成股份有限公司


DRAWN	ROGER YEH	DATE	2024/12/19	RECHECKED	Steven Yu	DATE	2024/12/19
DESIGNED	ROGER YEH	DATE	2024/12/19	APPROVED	JOSEPH LEE	DATE	2024/12/19

TITLE

FLOW DIAGRAM-
PIPING SYSTEM
(1)
FAB A

PROJECT	FAB22 Phase 2 PROJECT
PACKAGE NAME	MEP SYSTEM
DRAWING NAME	F22P2-M-2-F-01
SCALE	NOT TO SCALE
FILE NAME	F22P2-M-2-F-01

UNIT	mm
Rev	

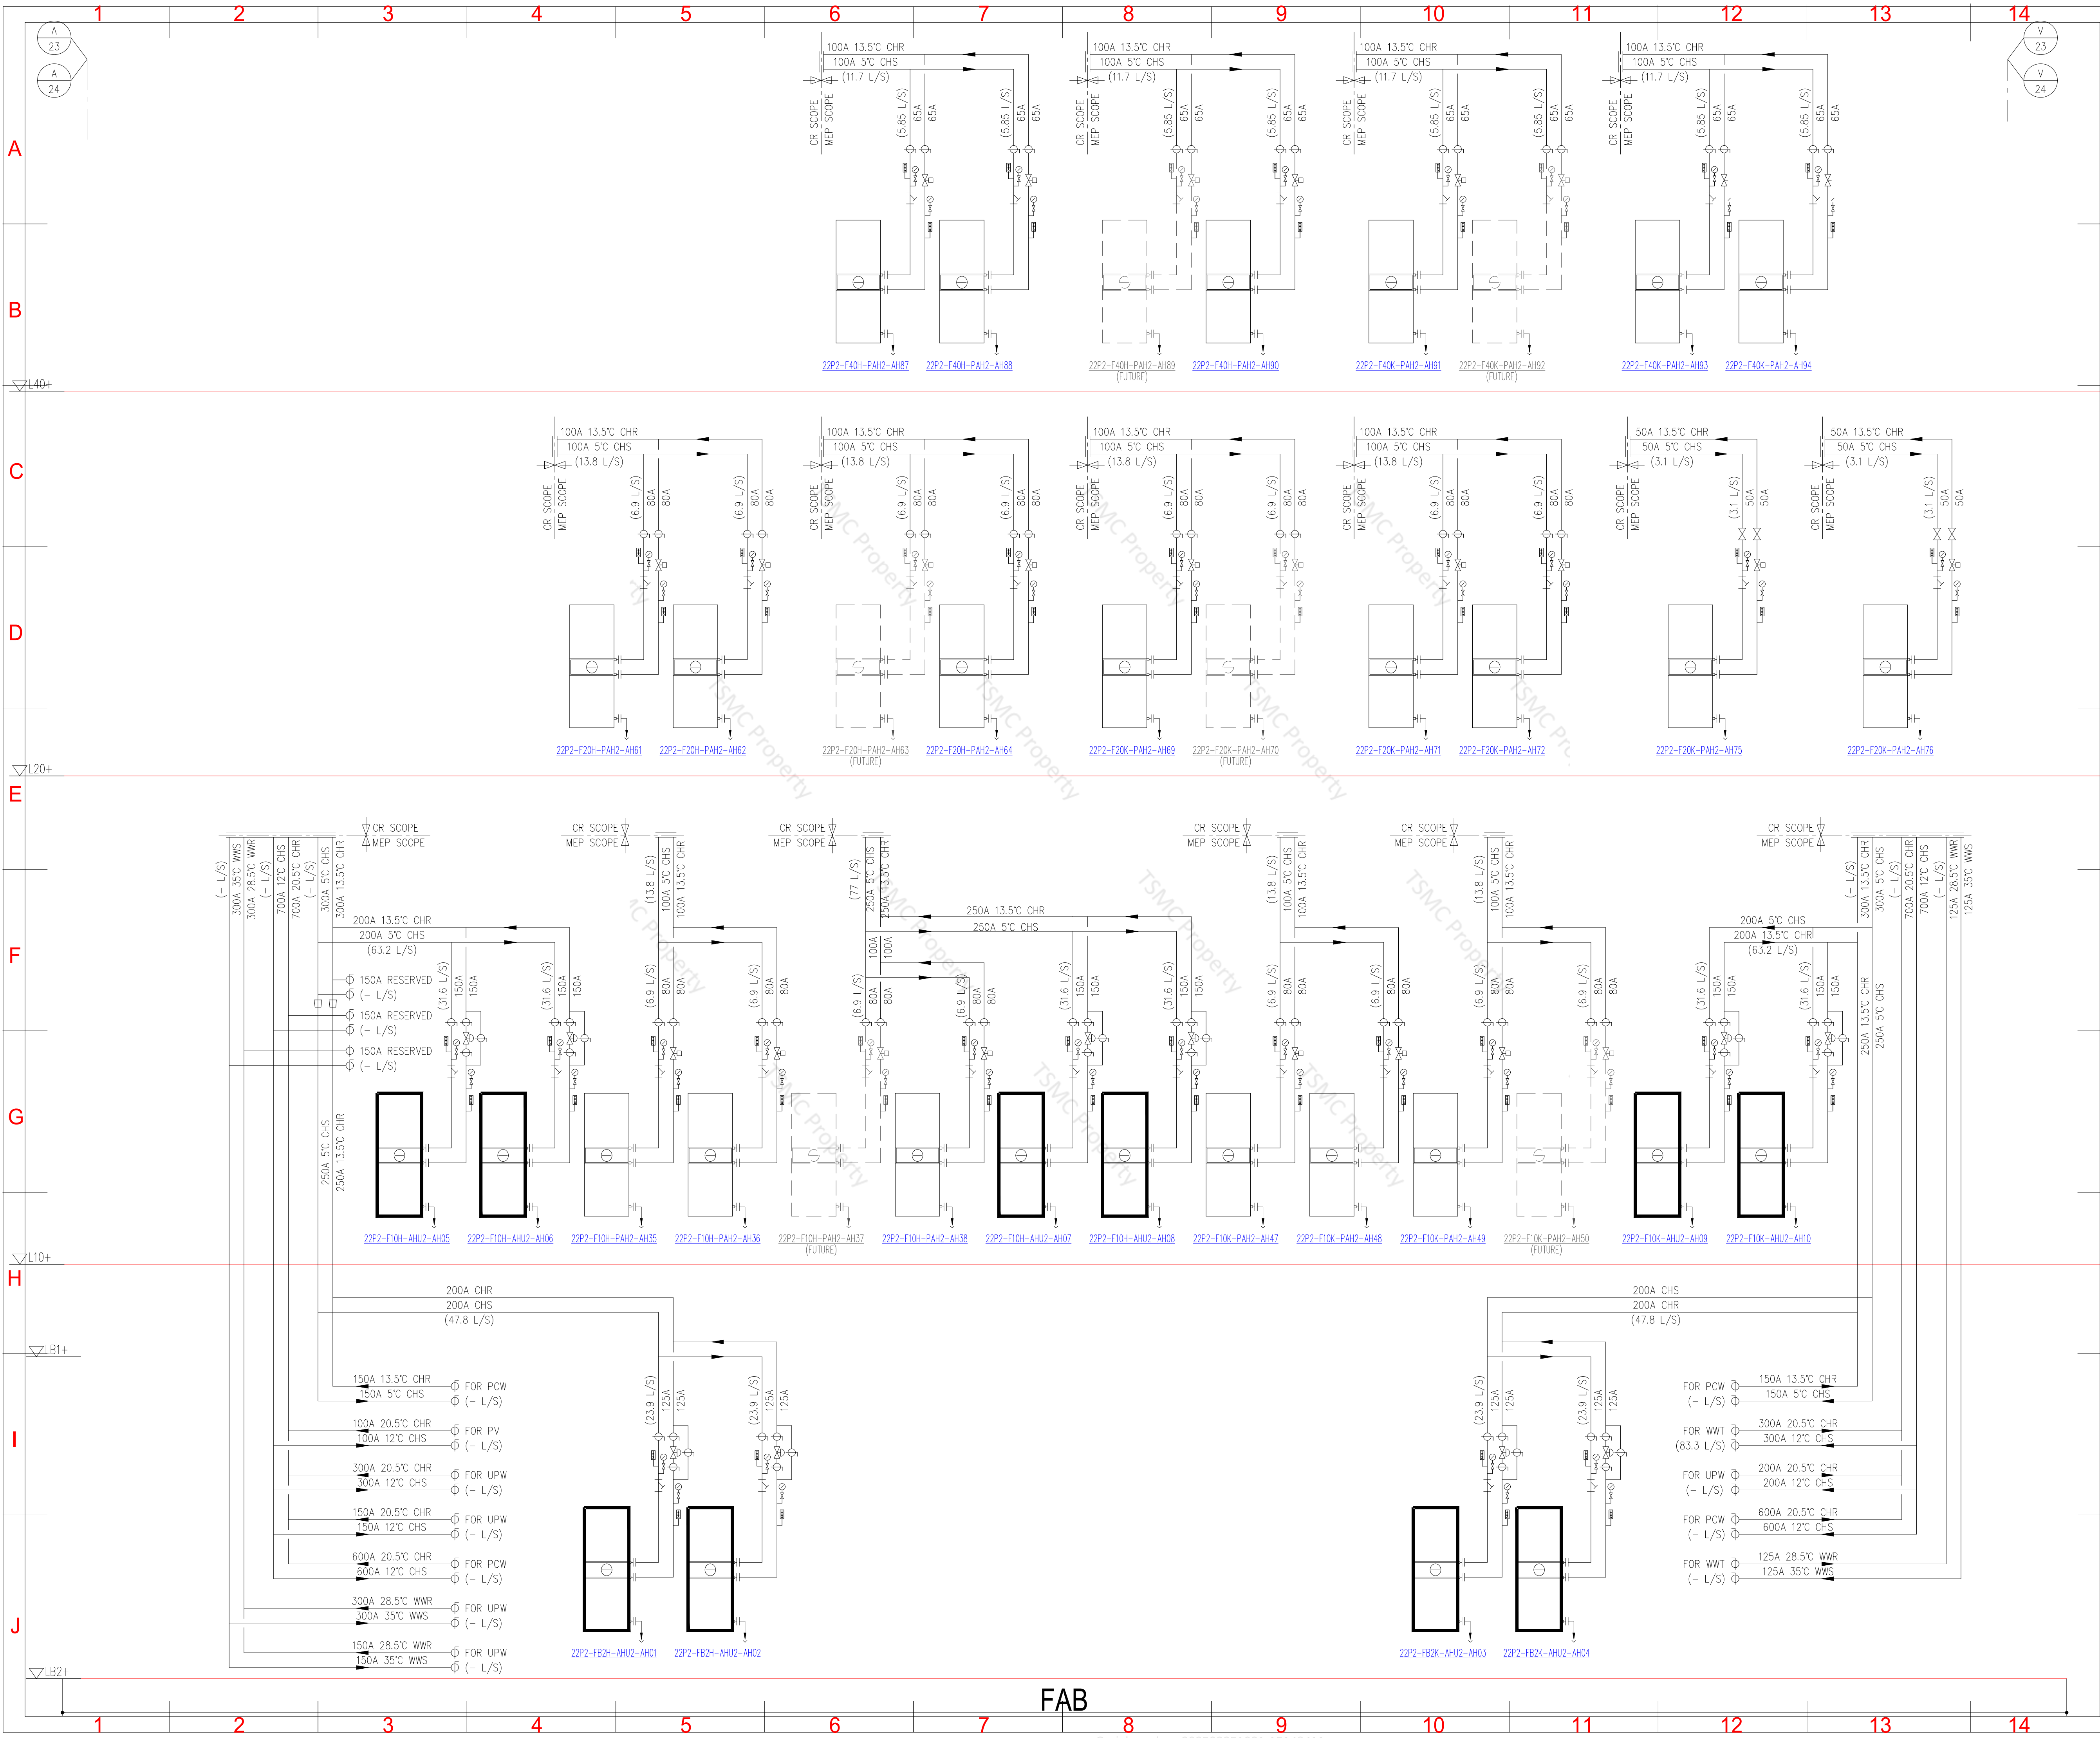

KEY PLANT

Building Code

- A: Office
- F: FAB
- H: HPM
- C: CUP
- G: Gas Yard & BSGS
- N: Supporting
- W: Warehouse

版次	日期	修正者	修正
VER.	DATE	REVIEW	REVISION

台灣積體電路製造股份有限公司
Taiwan Semiconductor Manufacturing Company, Ltd.

ACCEPTANCE REVIEWED	DATE	ACCEPTANCE REVIEWED	DATE

CONTRACTOR


漢唐集成股份有限公司
United Integrated Service

DRAWN	ROGER YEH	DATE	2024/12/19	RECHECKED	Steven Yu	DATE	2024/12/19
DESIGNED	ROGER YEH	DATE	2024/12/19	APPROVED	JOSEPH LEE	DATE	2024/12/19

TITLE


FLOW DIAGRAM-
PIPING SYSTEM
(2)
FAB B

PROJECT	FAB22 Phase 2 PROJECT
PACKAGE NAME	MEP SYSTEM
DRAWING NAME	F22P2-M-2-F-02
SCALE	NOT TO SCALE
FILE NAME	F22P2-M-2-F-02
UNIT	mm
Rev	


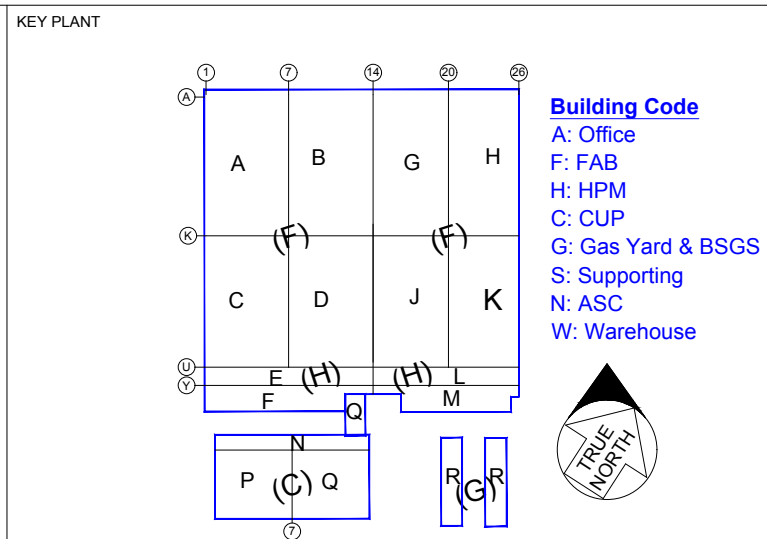


紙式 VER.	日期 DATE	修正者 REV BY	修正 REVISION	
				
台灣積體電路製造股份有限公司 Taiwan Semiconductor Manufacturing Company, Ltd.				
ACCEPTANCE REVIEWED	DATE	ACCEPTANCE REVIEWED	DATE	
CONTRACTOR				
 漢唐集成股份有限公司				
DRAWN	ROGER YEH	DATE 2024/12/18	RECHECKED Steven Yu	DATE 2024/12/18
DESIGNED	ROGER YEH	DATE 2024/12/18	APPROVED JOSEPH LEE	DATE 2024/12/18
TITLE				
FLOW DIAGRAM- PIPING SYSTEM (3) FAB A				
PROJECT FAB22 Phase 2 PROJECT				
PACKAGE NAME MEP SYSTEM				
DRAWING NAME F22P2-M-2-F-03				
SCALE				UNIT mm
NOT TO SCALE				
FILE NAME F22P2-M-2-F-03				Rev.



Name: X:\G2000\02_Drawings\MEP\FAB\MF22P2-M-2-F-03.dwg User: nicky-3121 Date: 10/4/24 - 4:39pm

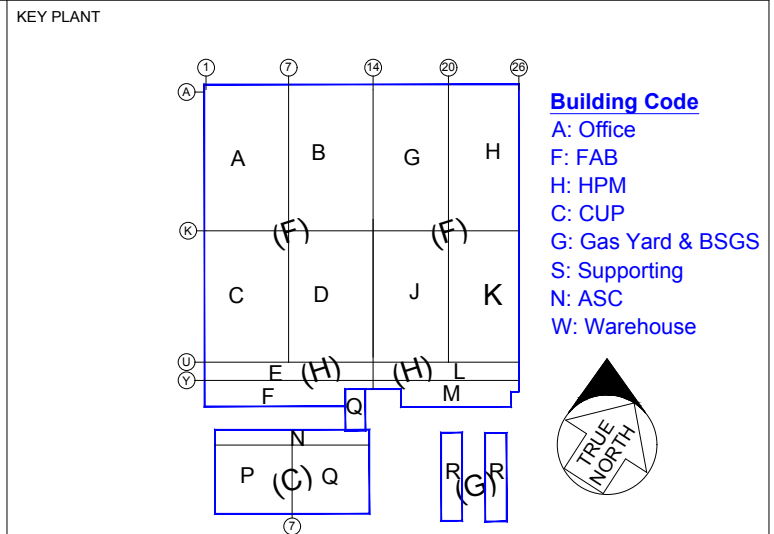


Name: X:\G200002_Drawings\MEP\FAB\MEF22P2-M-2-F-04.dwg User: nicky-3121 Date: 10/11/24 - 4:39pm

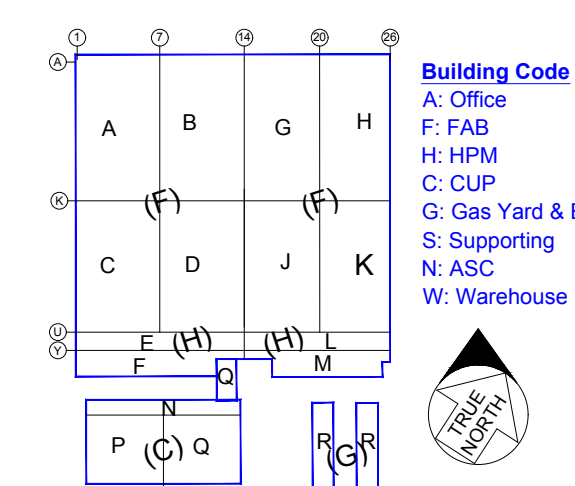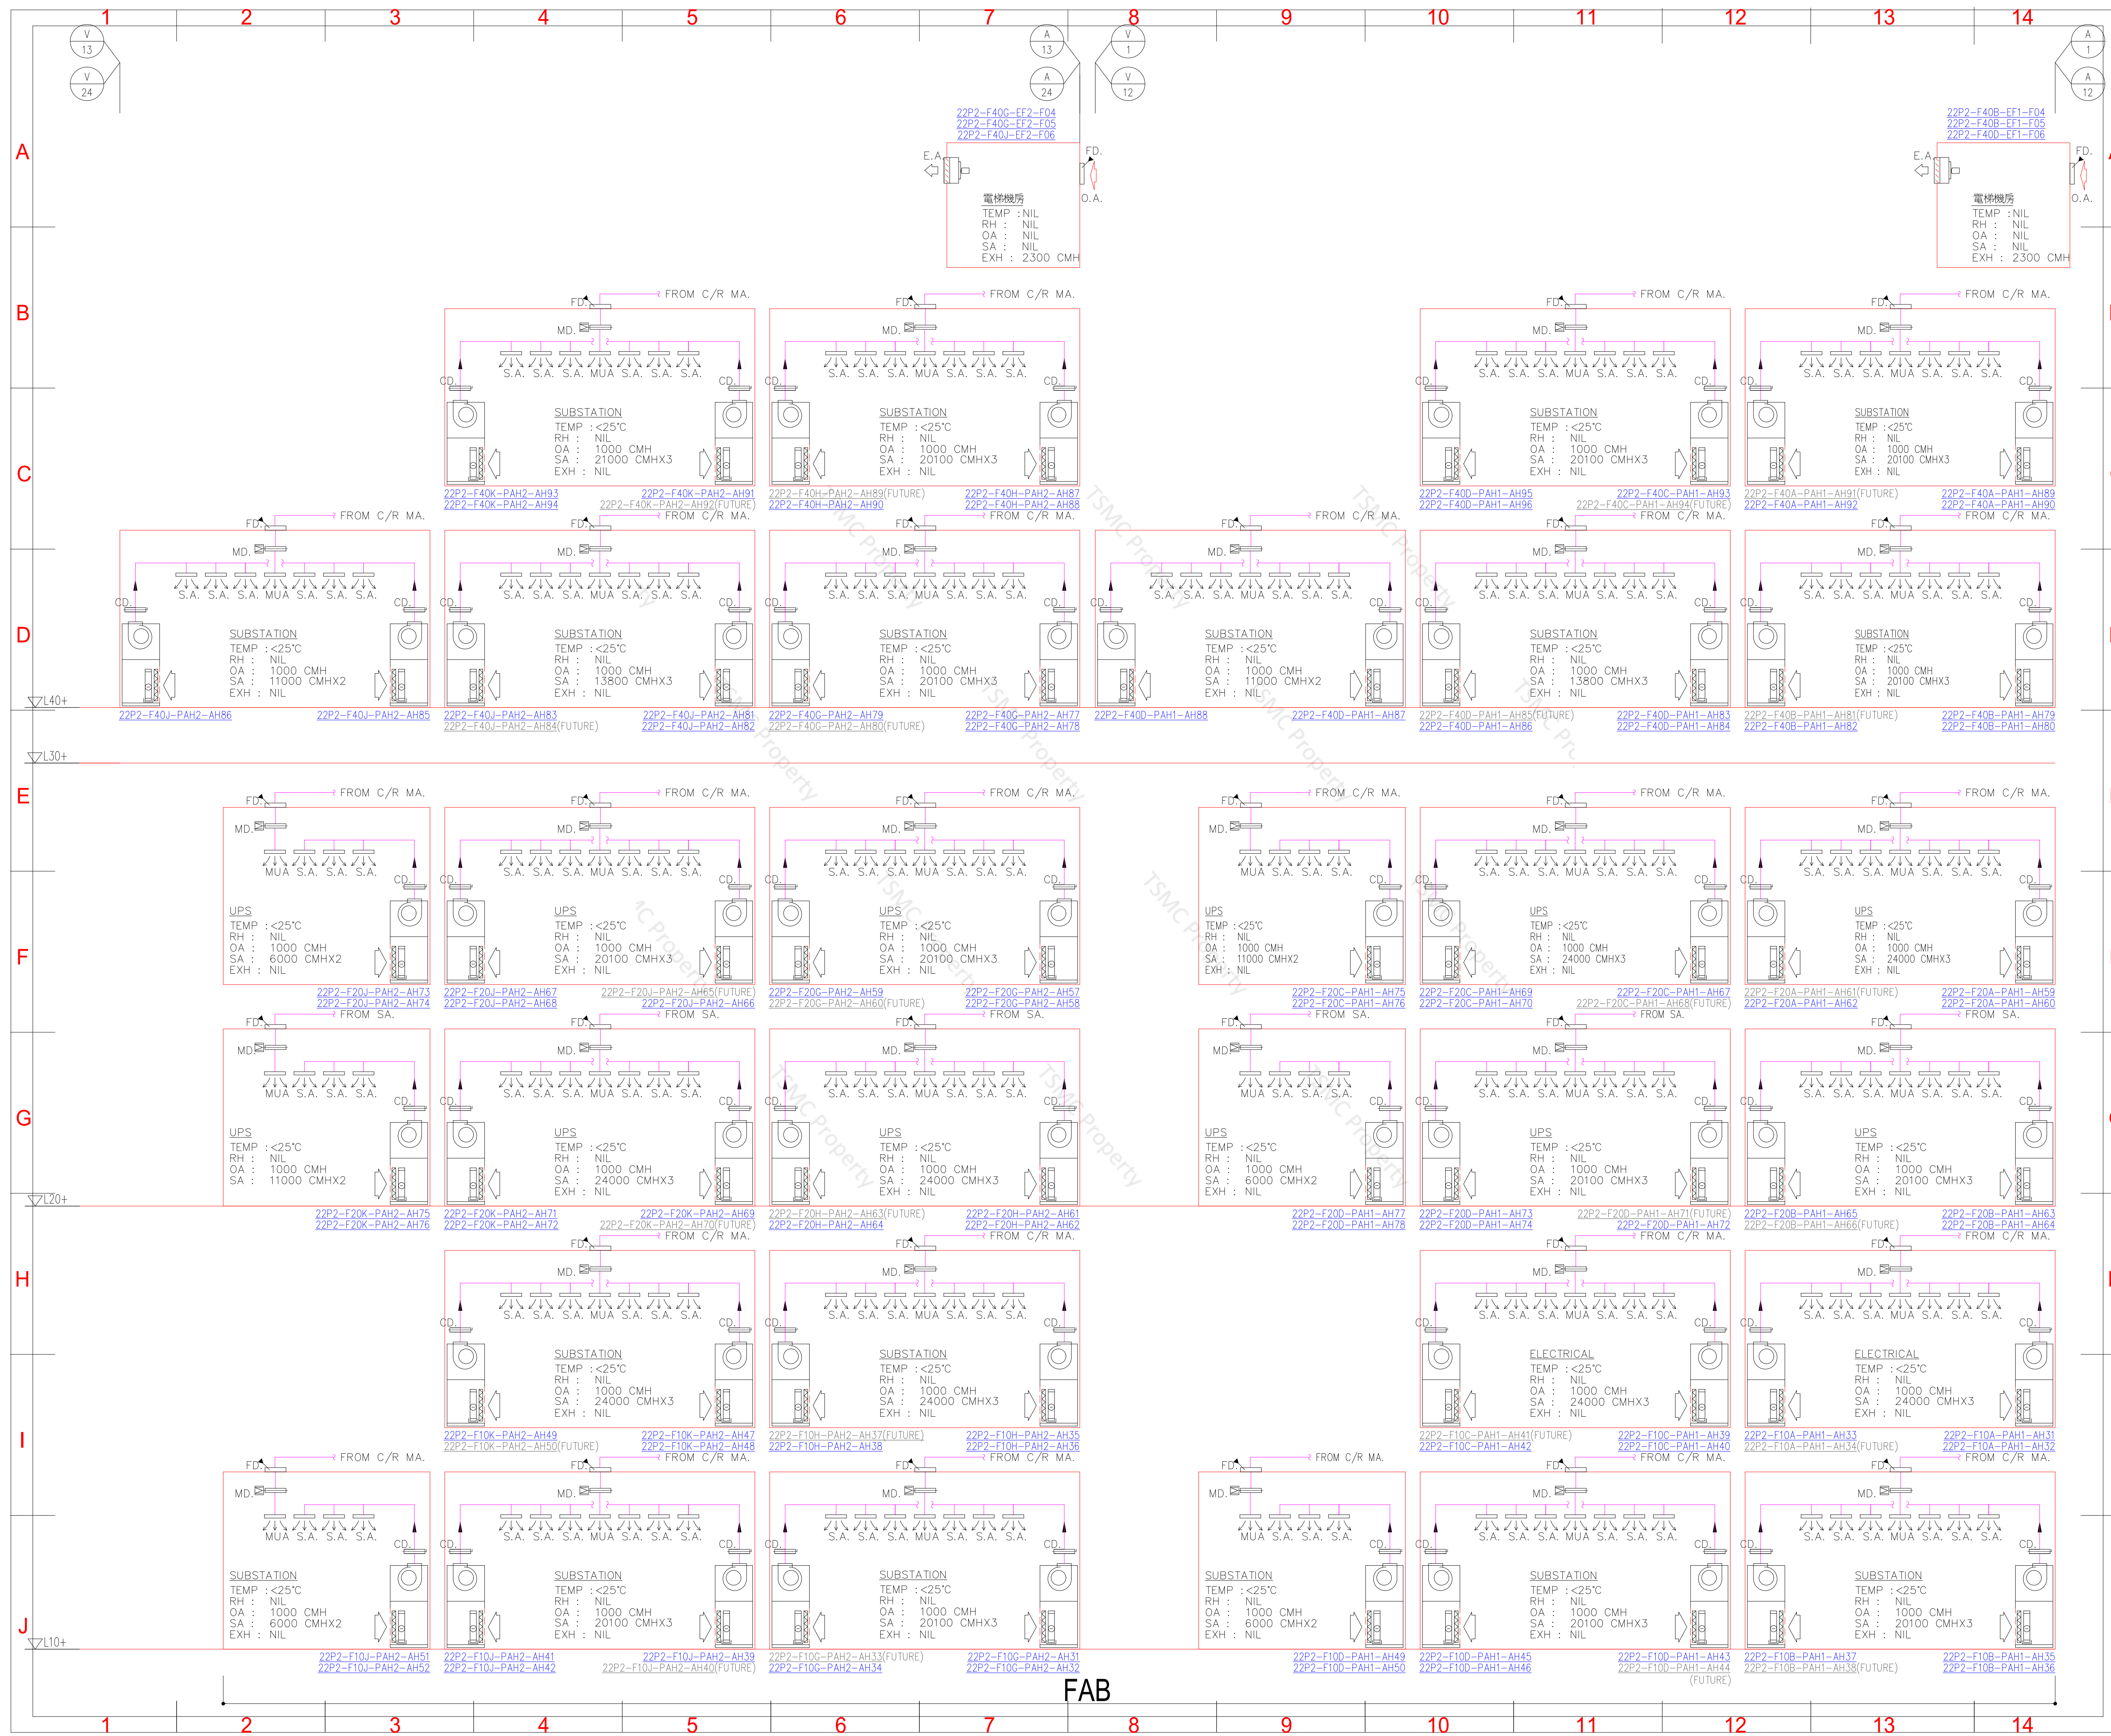


修 正 VER.		修 正 DATE		修 正 REV/VERSION		修 正 VERSION	
							
台灣積體電路製造股份有限公司 Taiwan Semiconductor Manufacturing Company, Ltd.							
ACCEPTANCE REVIEWED		DATE		ACCEPTANCE REVIEWED		DATE	
CONTRACTOR							
 漢唐集成股份有限公司							
DRAWN		DATE		RECHECKED		DATE	
ROGER YEH		2024/12/18		Steven Yu		2024/12/18	
DESIGNED		DATE		APPROVED		DATE	
ROGER YEH		2024/12/18		JOSEPH LEE		2024/12/18	
TITLE							
FLOW DIAGRAM- DUCTING SYSTEM (1) FAB							
PROJECT							
FAB22 Phase 2 PROJECT							
PACKAGE NAME							
MEP SYSTEM							
DRAWING NAME							
F22P2-M-2-F-05							
SCALE							UNIT
							mm
FILE NAME							Rev.
F22P2-M-2-F-05							

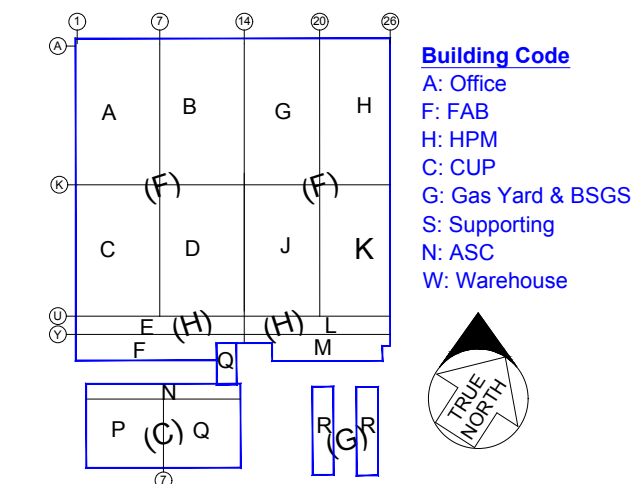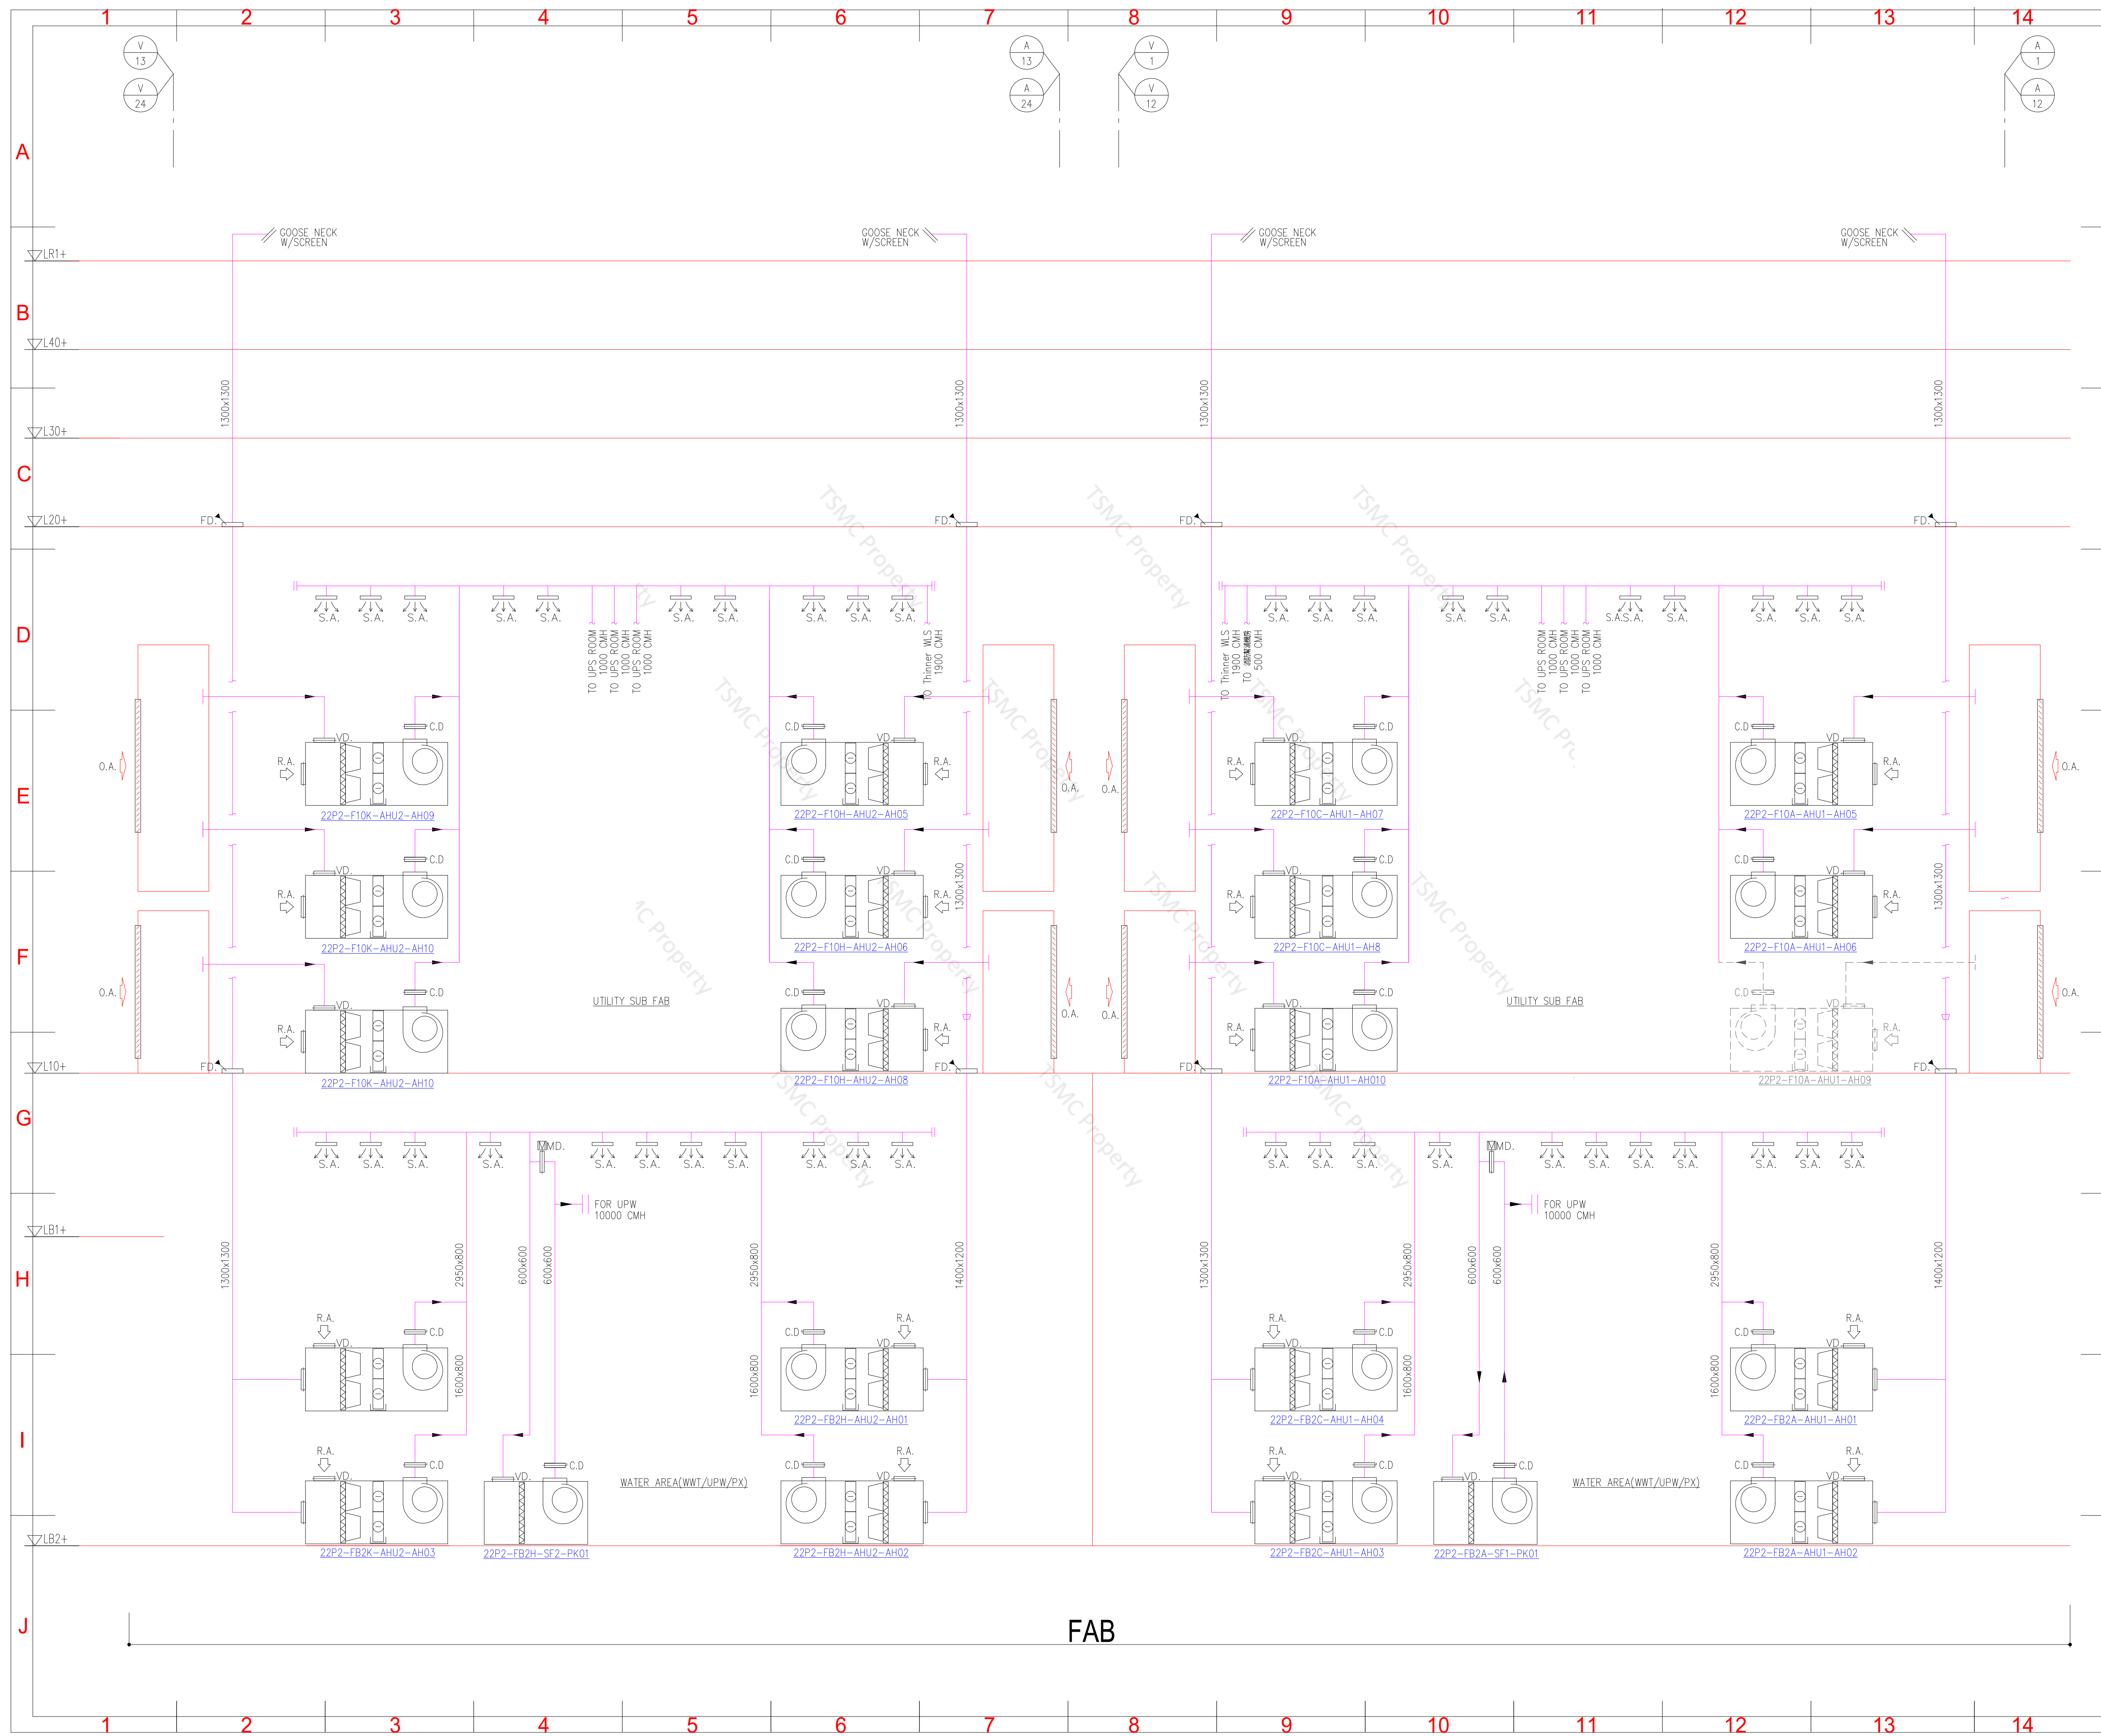

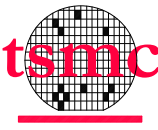格式 VER.	日期 DATE	修正者 REV. BY	修 正 REVISION	
				
台灣積體電路製造股份有限公司 Taiwan Semiconductor Manufacturing Company, Ltd.				
ACCEPTANCE REVIEWED		DATE	ACCEPTANCE REVIEWED	
CONTRACTOR				
 漢唐集成股份有限公司				
DRAWN	ROGER YEH	DATE 2024/12/10	RECHECKED Steven Yu	DATE 2024/12/10
DESIGNED	ROGER YEH	DATE 2024/12/10	APPROVED JOSEPH LEE	DATE 2024/12/10
TITLE FLOW DIAGRAM- DUCTING SYSTEM (3) FAB				
PROJECT FAB22 Phase 2 PROJECT				
PACKAGE NAME MEP SYSTEM				
DRAWING NAME F22P2-M-2-F-07				
SCALE				UNIT mm
NOT TO SCALE				
FILE NAME F22P2-M-2-F-07				Rev.

Name: X:\G200002 Drawings\MEP\FAB\MF22P2.M2.E-07.dwg User: nick.v.3121 Date: 10/11/2024 4:30pm

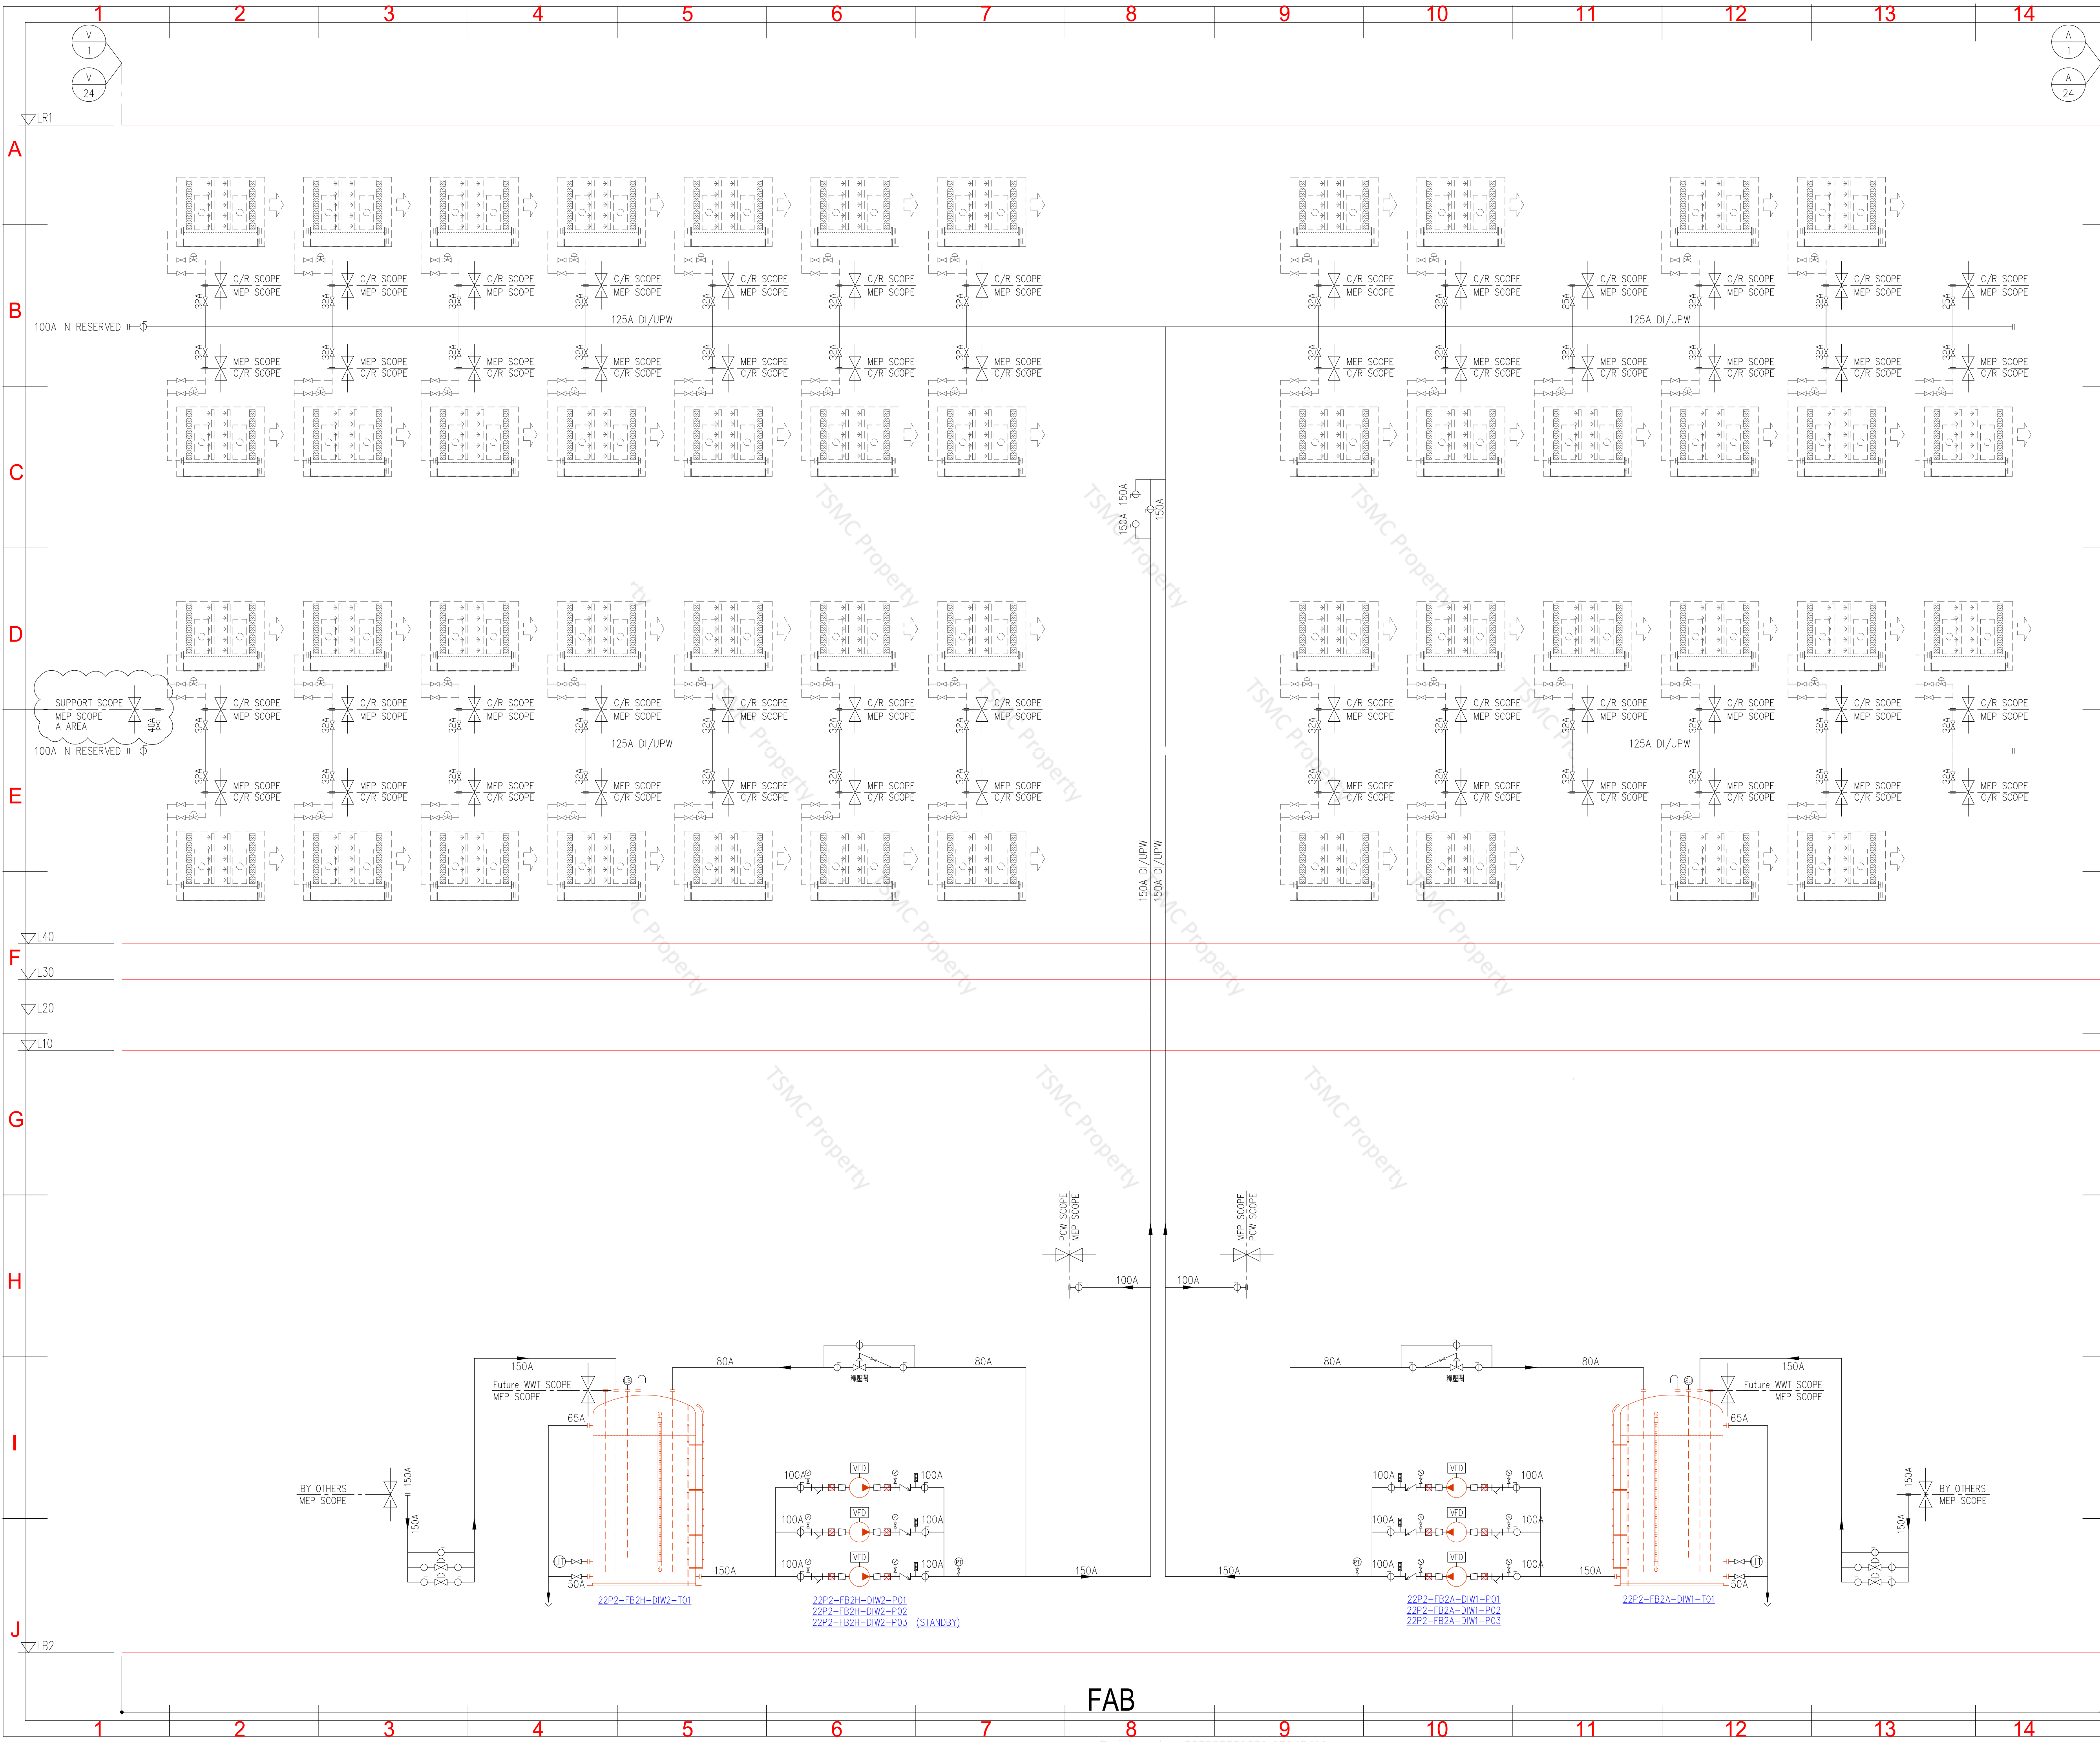

KEY PLAN

Building Code

- A: Office
- F: FAB
- C: CUP
- G: Gas Yard & BSGS
- S: Supporting
- N: ASC
- W: Warehouse

順次 VER.	日期 DATE	修正者 REV BY	修正 REVISION

台灣積體電路製造股份有限公司
Taiwan Semiconductor Manufacturing Company, Ltd.



ACCEPTANCE REVIEWED	DATE	ACCEPTANCE REVIEWED	DATE



CONTRACTOR

漢唐集成股份有限公司
United Integrated Services

DRAWN	ROGER YEH	DATE	2024/12/19	RECHECKED	Steven Yu	DATE	2024/12/19
DESIGNED	ROGER YEH	DATE	2024/12/19	APPROVED	JOSEPH LEE	DATE	2024/12/19
TITLE							
FLOW DIAGRAM- UPW/DI MAKE UP WATER SYSTEM (1) FAB							
PROJECT							
FAB22 Phase 2 PROJECT							
PACKAGE NAME							
MEP SYSTEM							
DRAWING NAME							
F22P2-M-2-F-08							
SCALE							
NOT TO SCALE							
FILE NAME							
F22P2-M-2-F-08							
UNIT							
mm							
Rev							

出圖日期: 2024/12/10

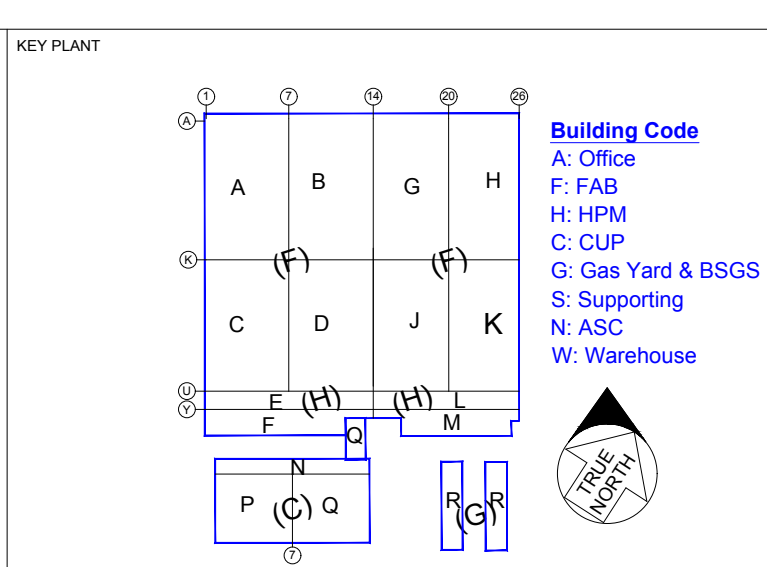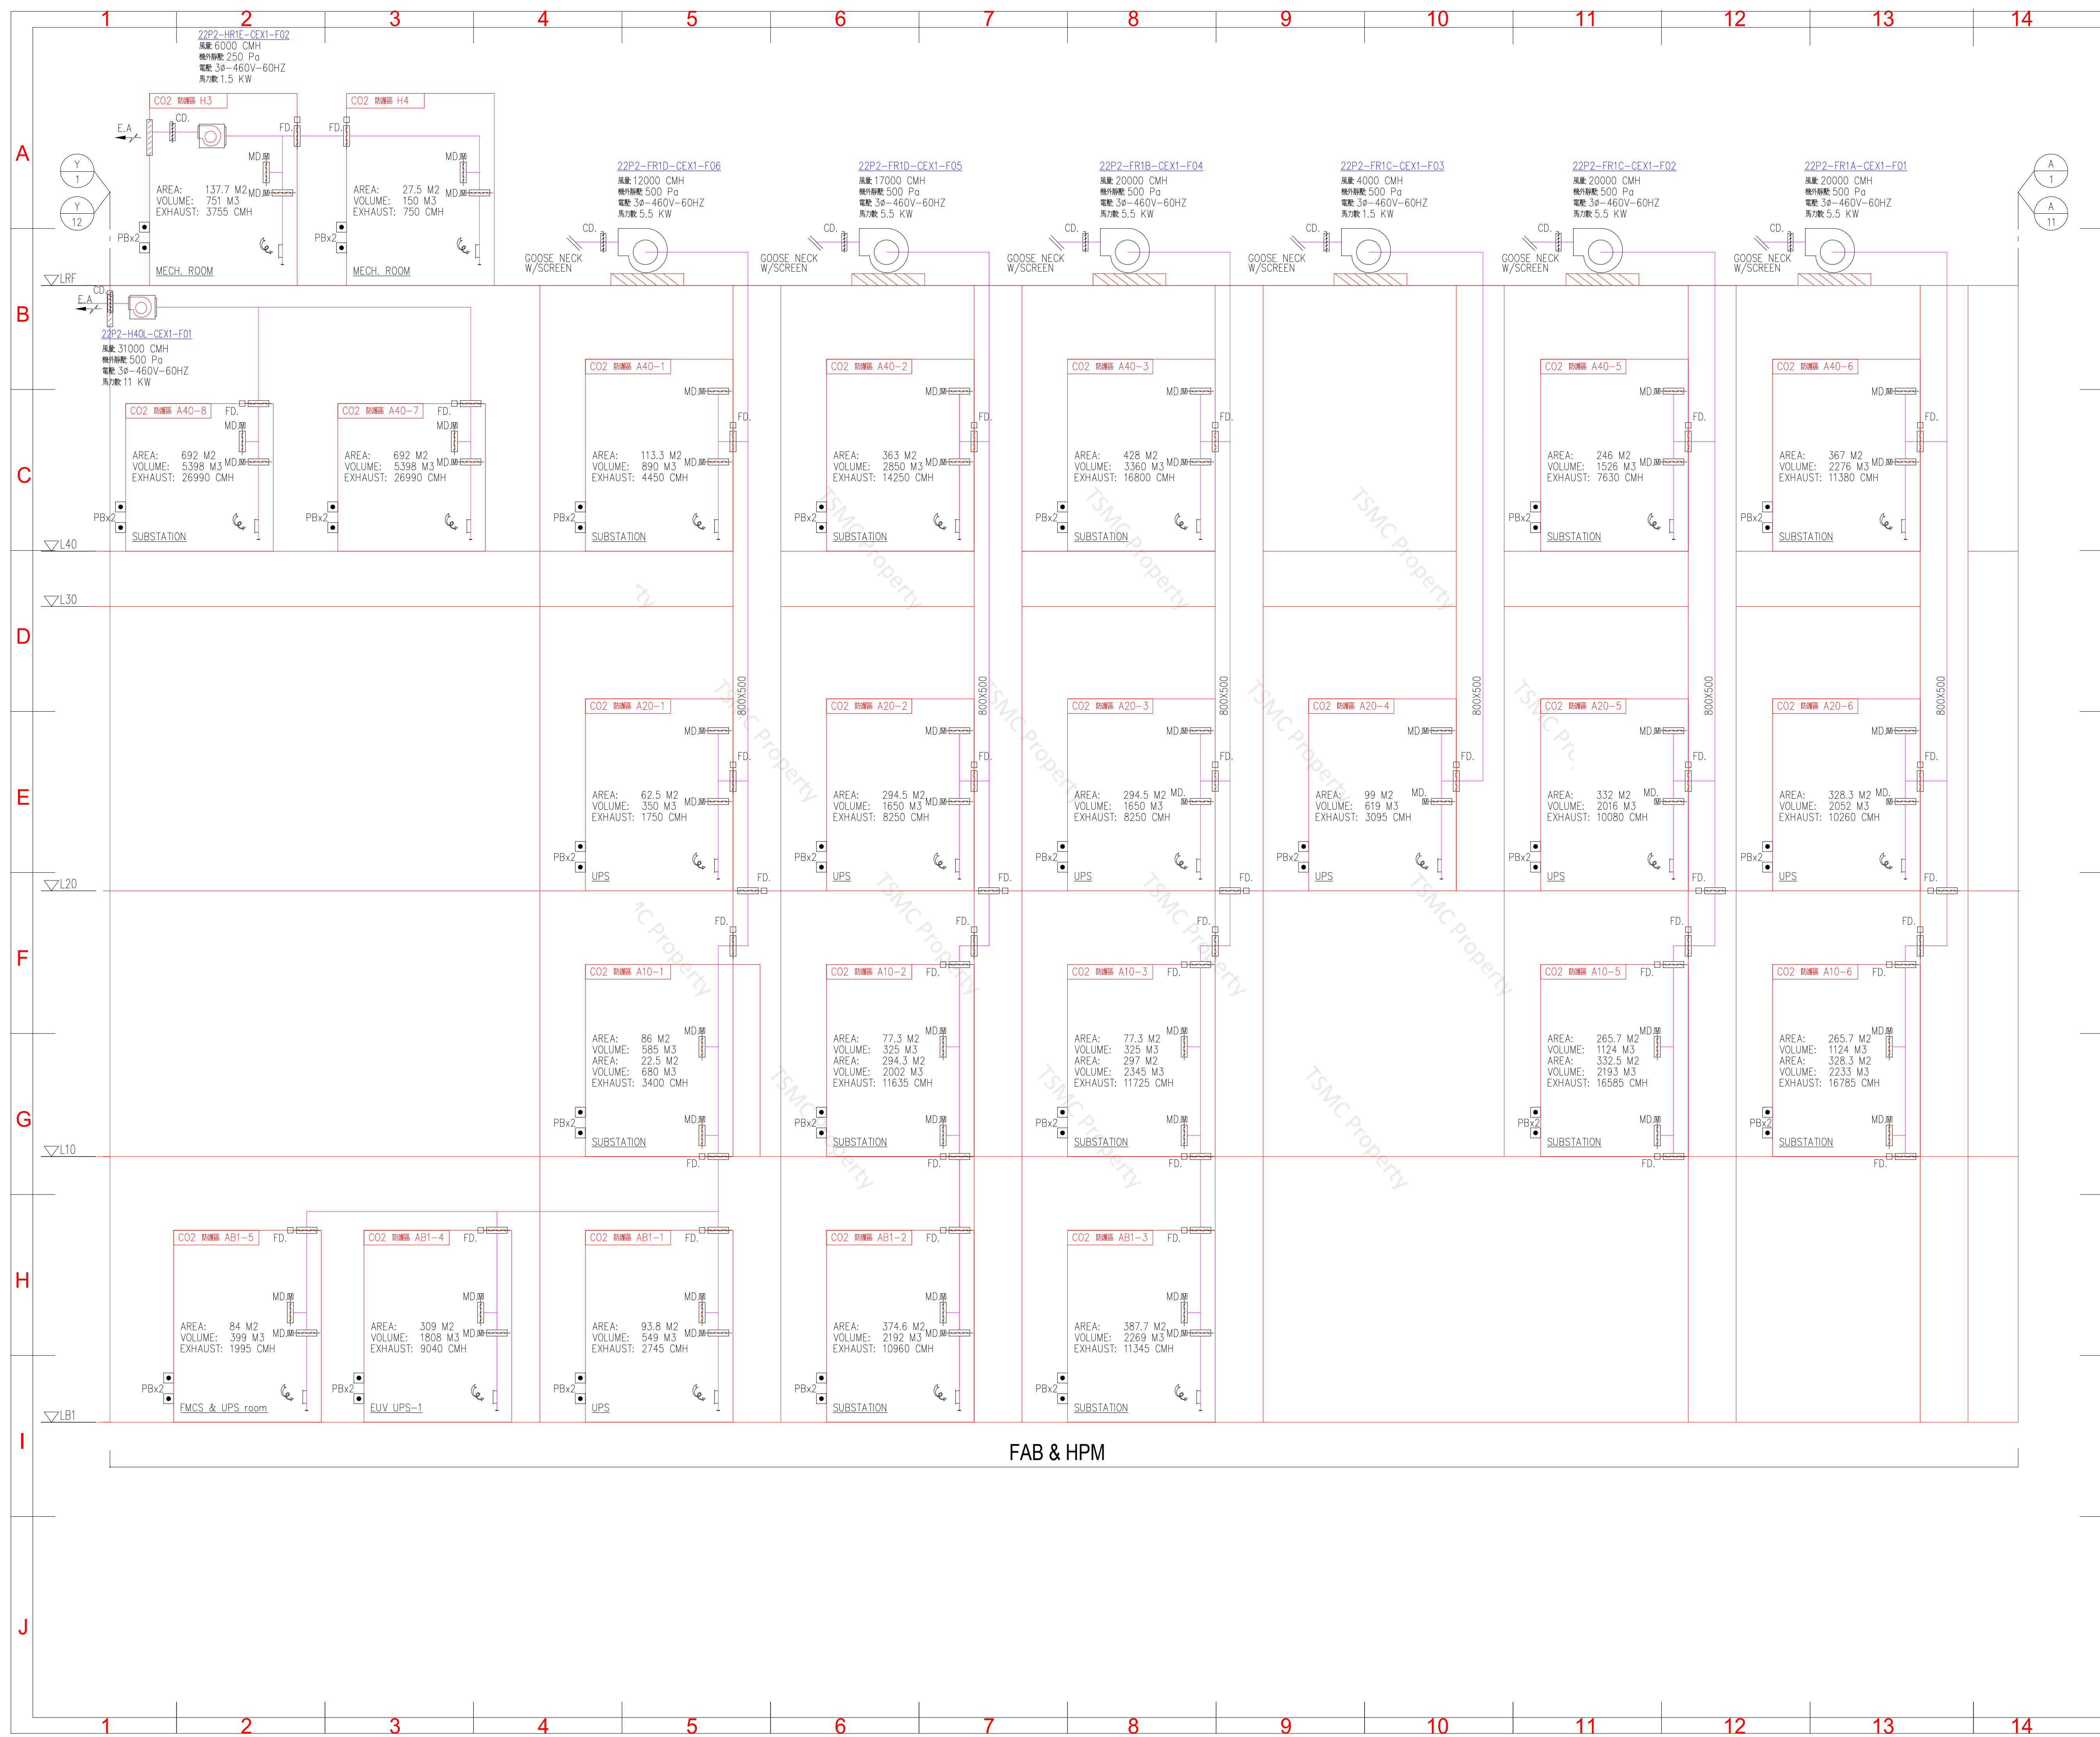[illegible]

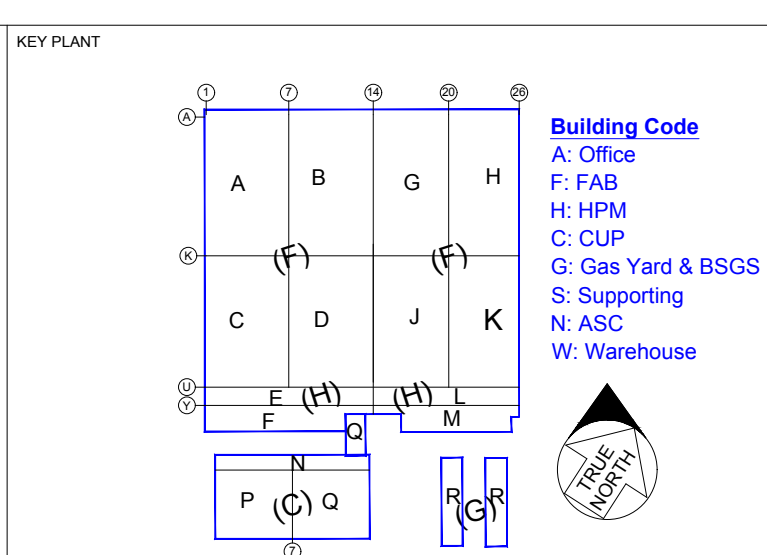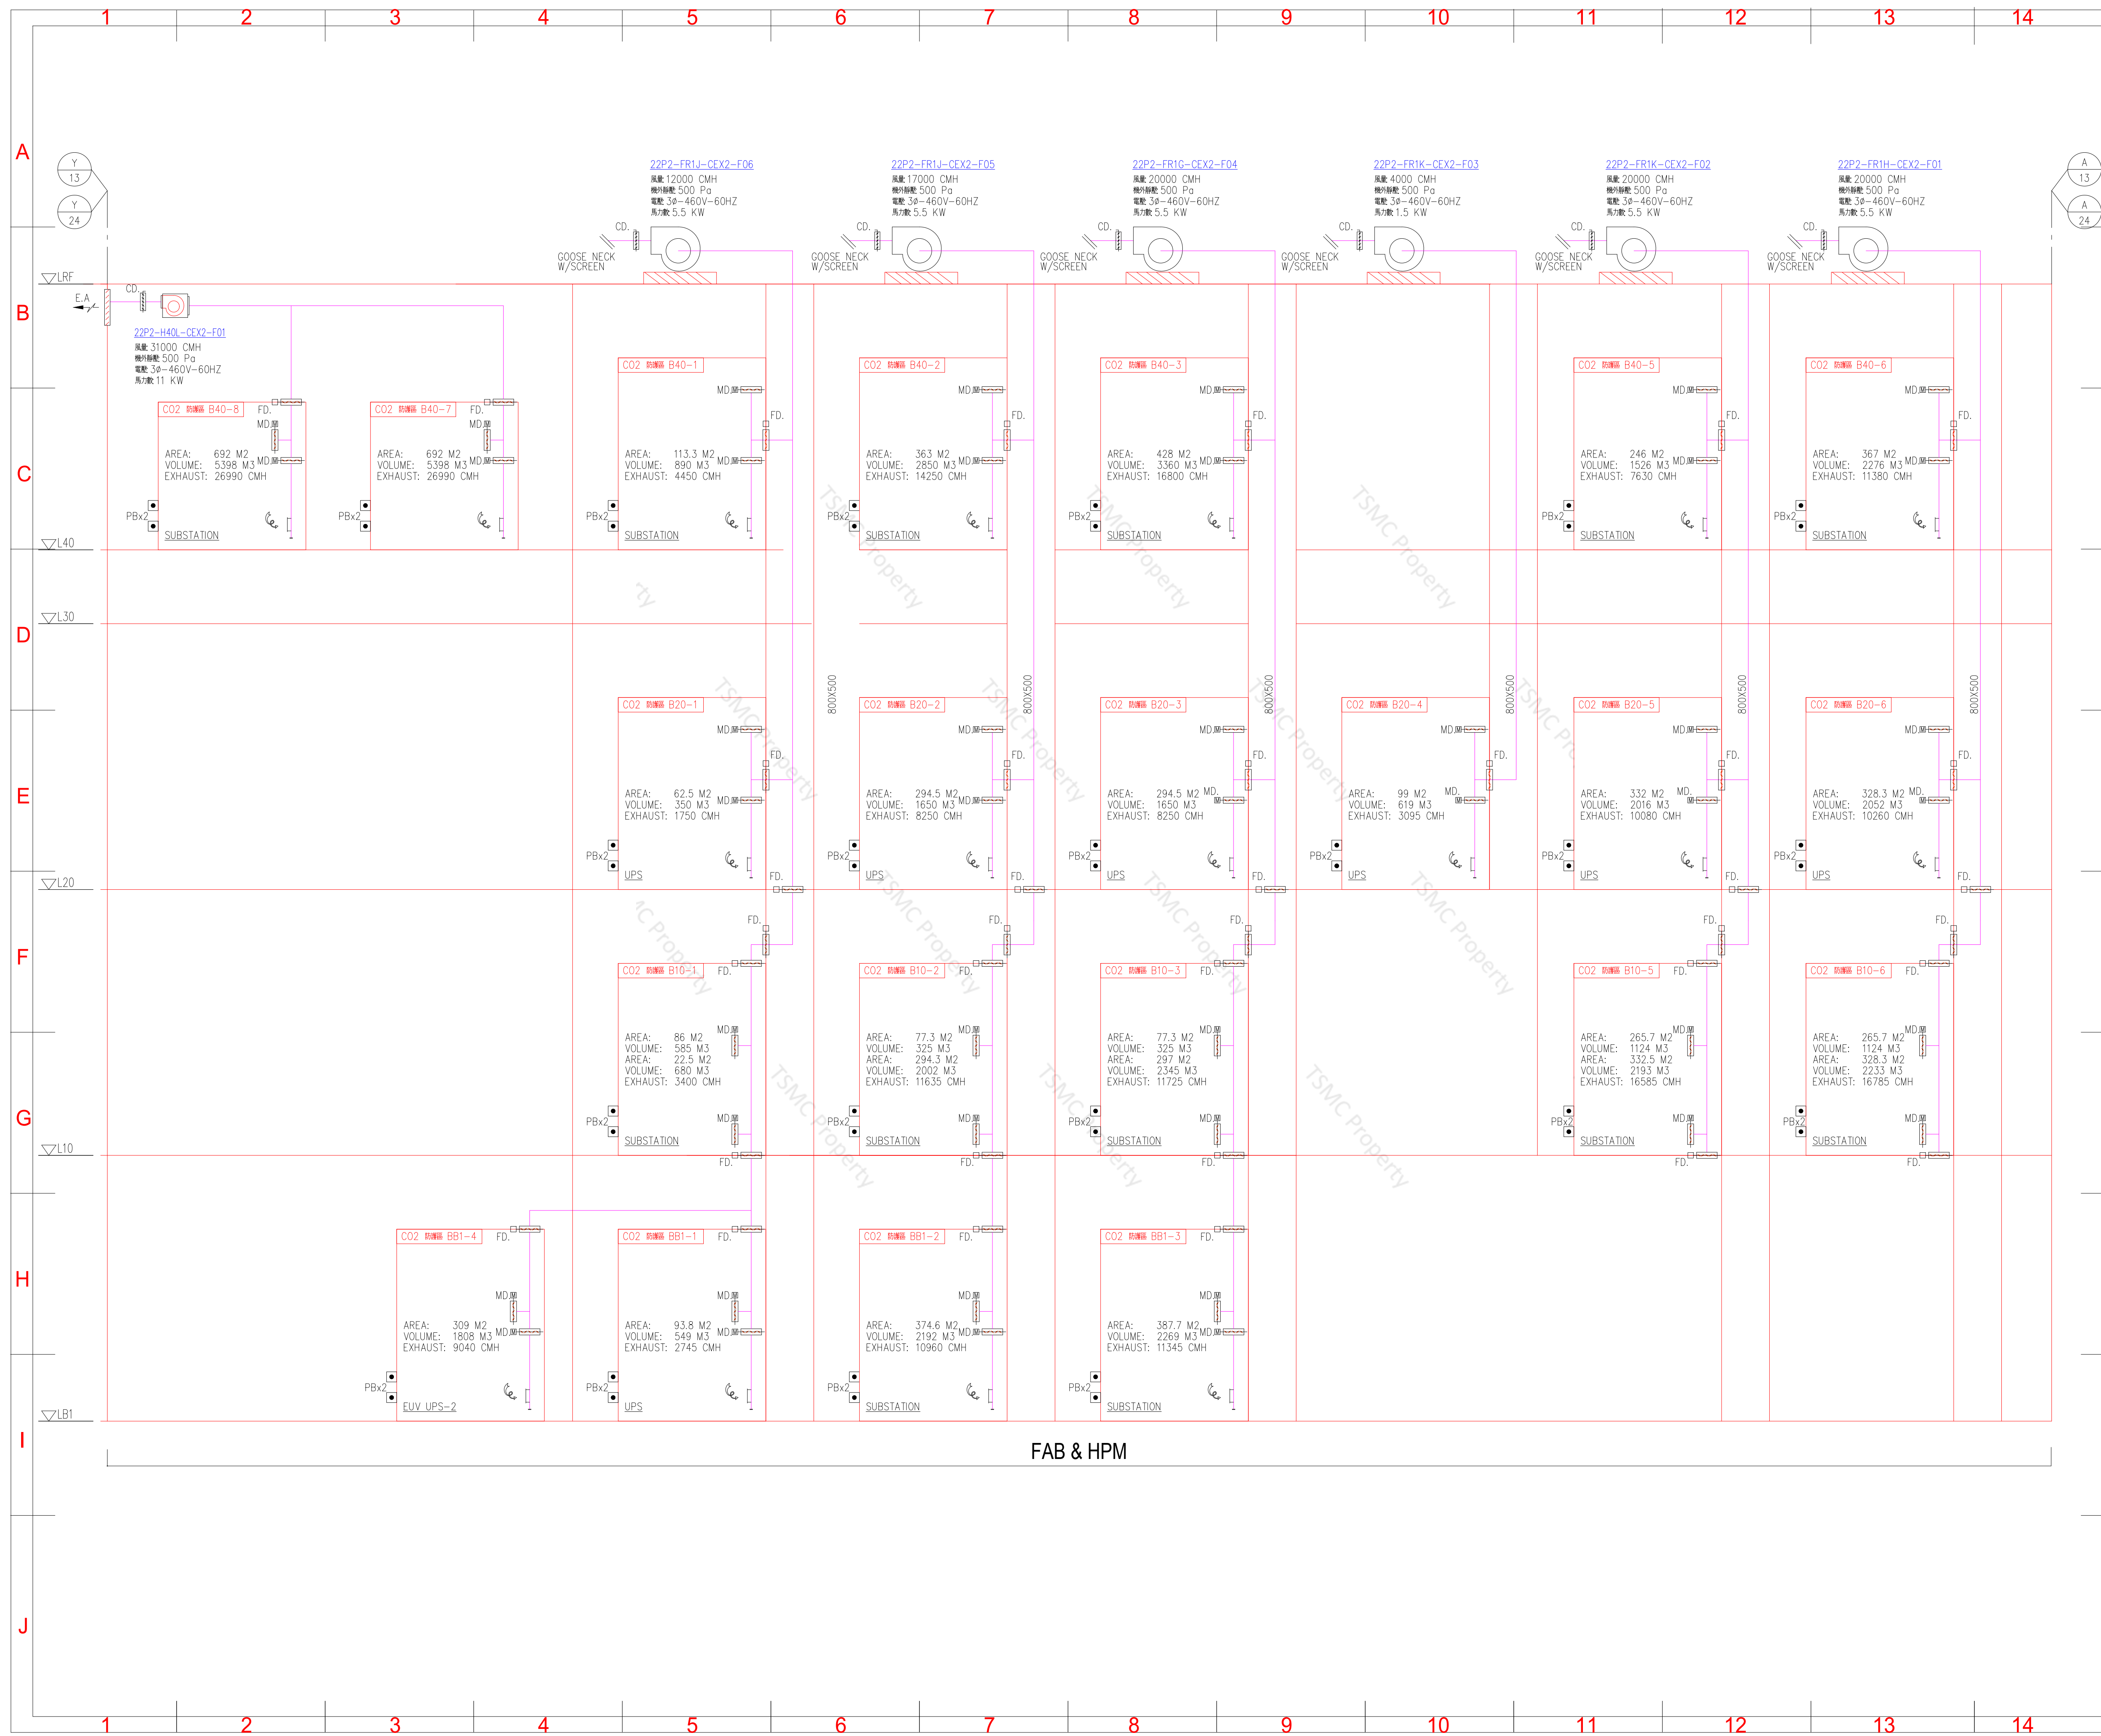[illegible]

版次 VER.	日期 DATE	修正者 REV BY	修 正 REVISION
------------	------------	---------------	-----------------



台灣積體電路製造股份有限公司
Taiwan Semiconductor Manufacturing Company, Ltd

ACCEPTANCE REVIEWED	DATE	ACCEPTANCE REVIEWED	DATE
---------------------	------	---------------------	------

CONTRACTOR


uis 漢唐集成股份有限公司
United Integrated Services

DRAWN ROGER YEY	DATE 2024/12/10	RECHECKED Steven Yu	DATE 2024/12/10
DESIGNED ROGER YEY	DATE 2024/12/10	APPROVED JOSEPH LEE	DATE 2024/12/10


TITLE

FLOW DIAGRAM-
CO2 EXHAUST SYSTEM
(2)
FAB B & HPM


PROJECT	FAB22 Phase 2 PROJECT	
PACKAGE NAME	MEP SYSTEM	
DRAWING NAME	F22P2-M-2-F-10	
SCALE	NOT TO SCALE	UNIT mm
FILE NAME	F22P2-M-2-F-10	Rev.

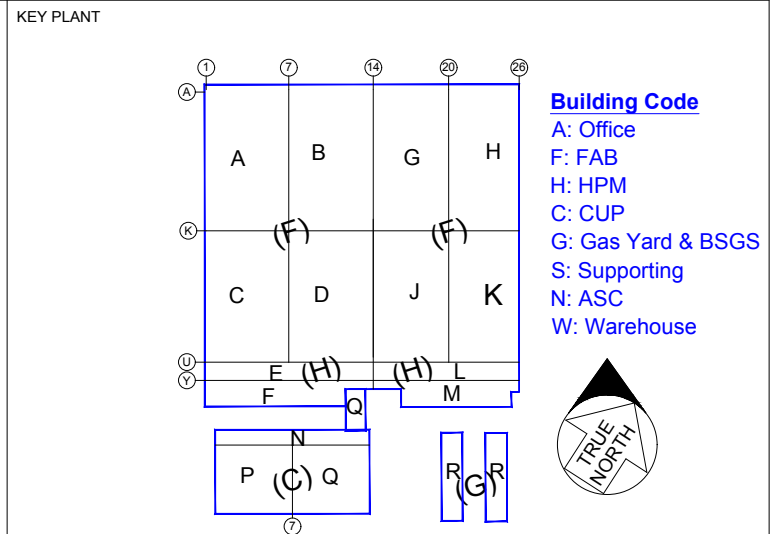


Name: X:\G200002_Drawings\MEP\FAB\VF22P2-M-2-F-11.dwg User: nicky-3121 Date: 10/4/24 4:40pm

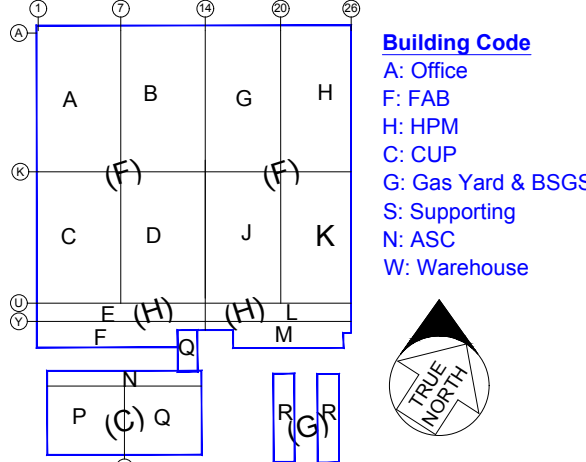


Name: X:\G200002 Drawings\MEP\FABM\VF22P2-M-2-H-01.dwg Date: 10/11/24 User: nicky-3121 10/24 - 4:40pm

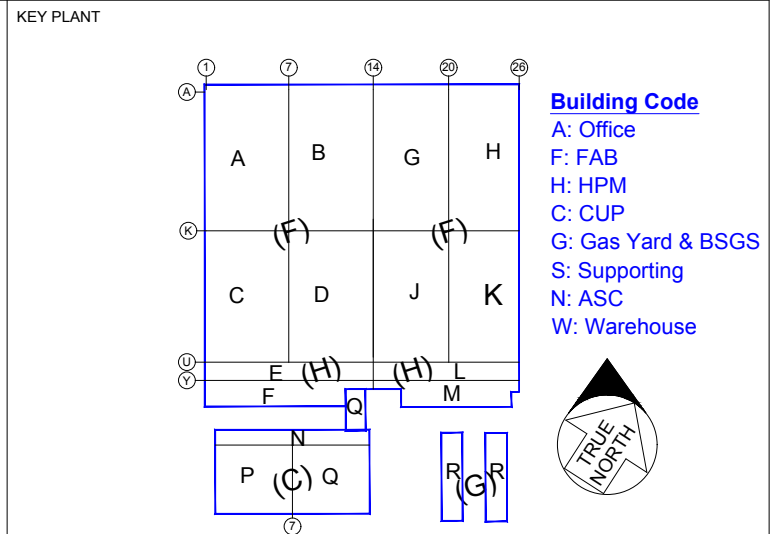

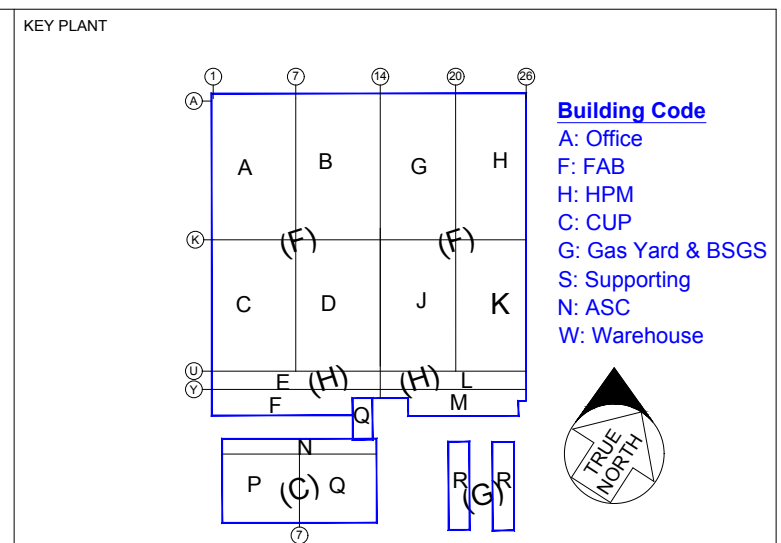

Building Code A: Office F: FAB H: HPM C: CUP G: Gas Yard & BSGS S: Supporting N: ASC W: Warehouse			
台 灣 積 體 電 路 製 造 股 份 有 限 公 司			
Taiwan Semiconductor Manufacturing Company, Ltd.			
ACCEPTANCE REVIEWED	DATE	ACCEPTANCE REVIEWED	DATE
CONTRACTOR			
uis 漢唐集成股份有限公司			
DRAWN	ROGER YEH	DATE	2024/12/10
DESIGNED	ROGER YEH	DATE	2024/12/10
TITLE			
FLOW DIAGRAM-DUCTING SYSTEM (1) HPM			
PROJECT			
FAB22 Phase 2 PROJECT			
PACKAGE NAME			
MEP SYSTEM			
DRAWING NAME			
F22P2-M-2-H-03			
SCALE			UNIT
NOT TO SCALE			mm
FILE NAME			Rev
F22P2-M-2-H-03			

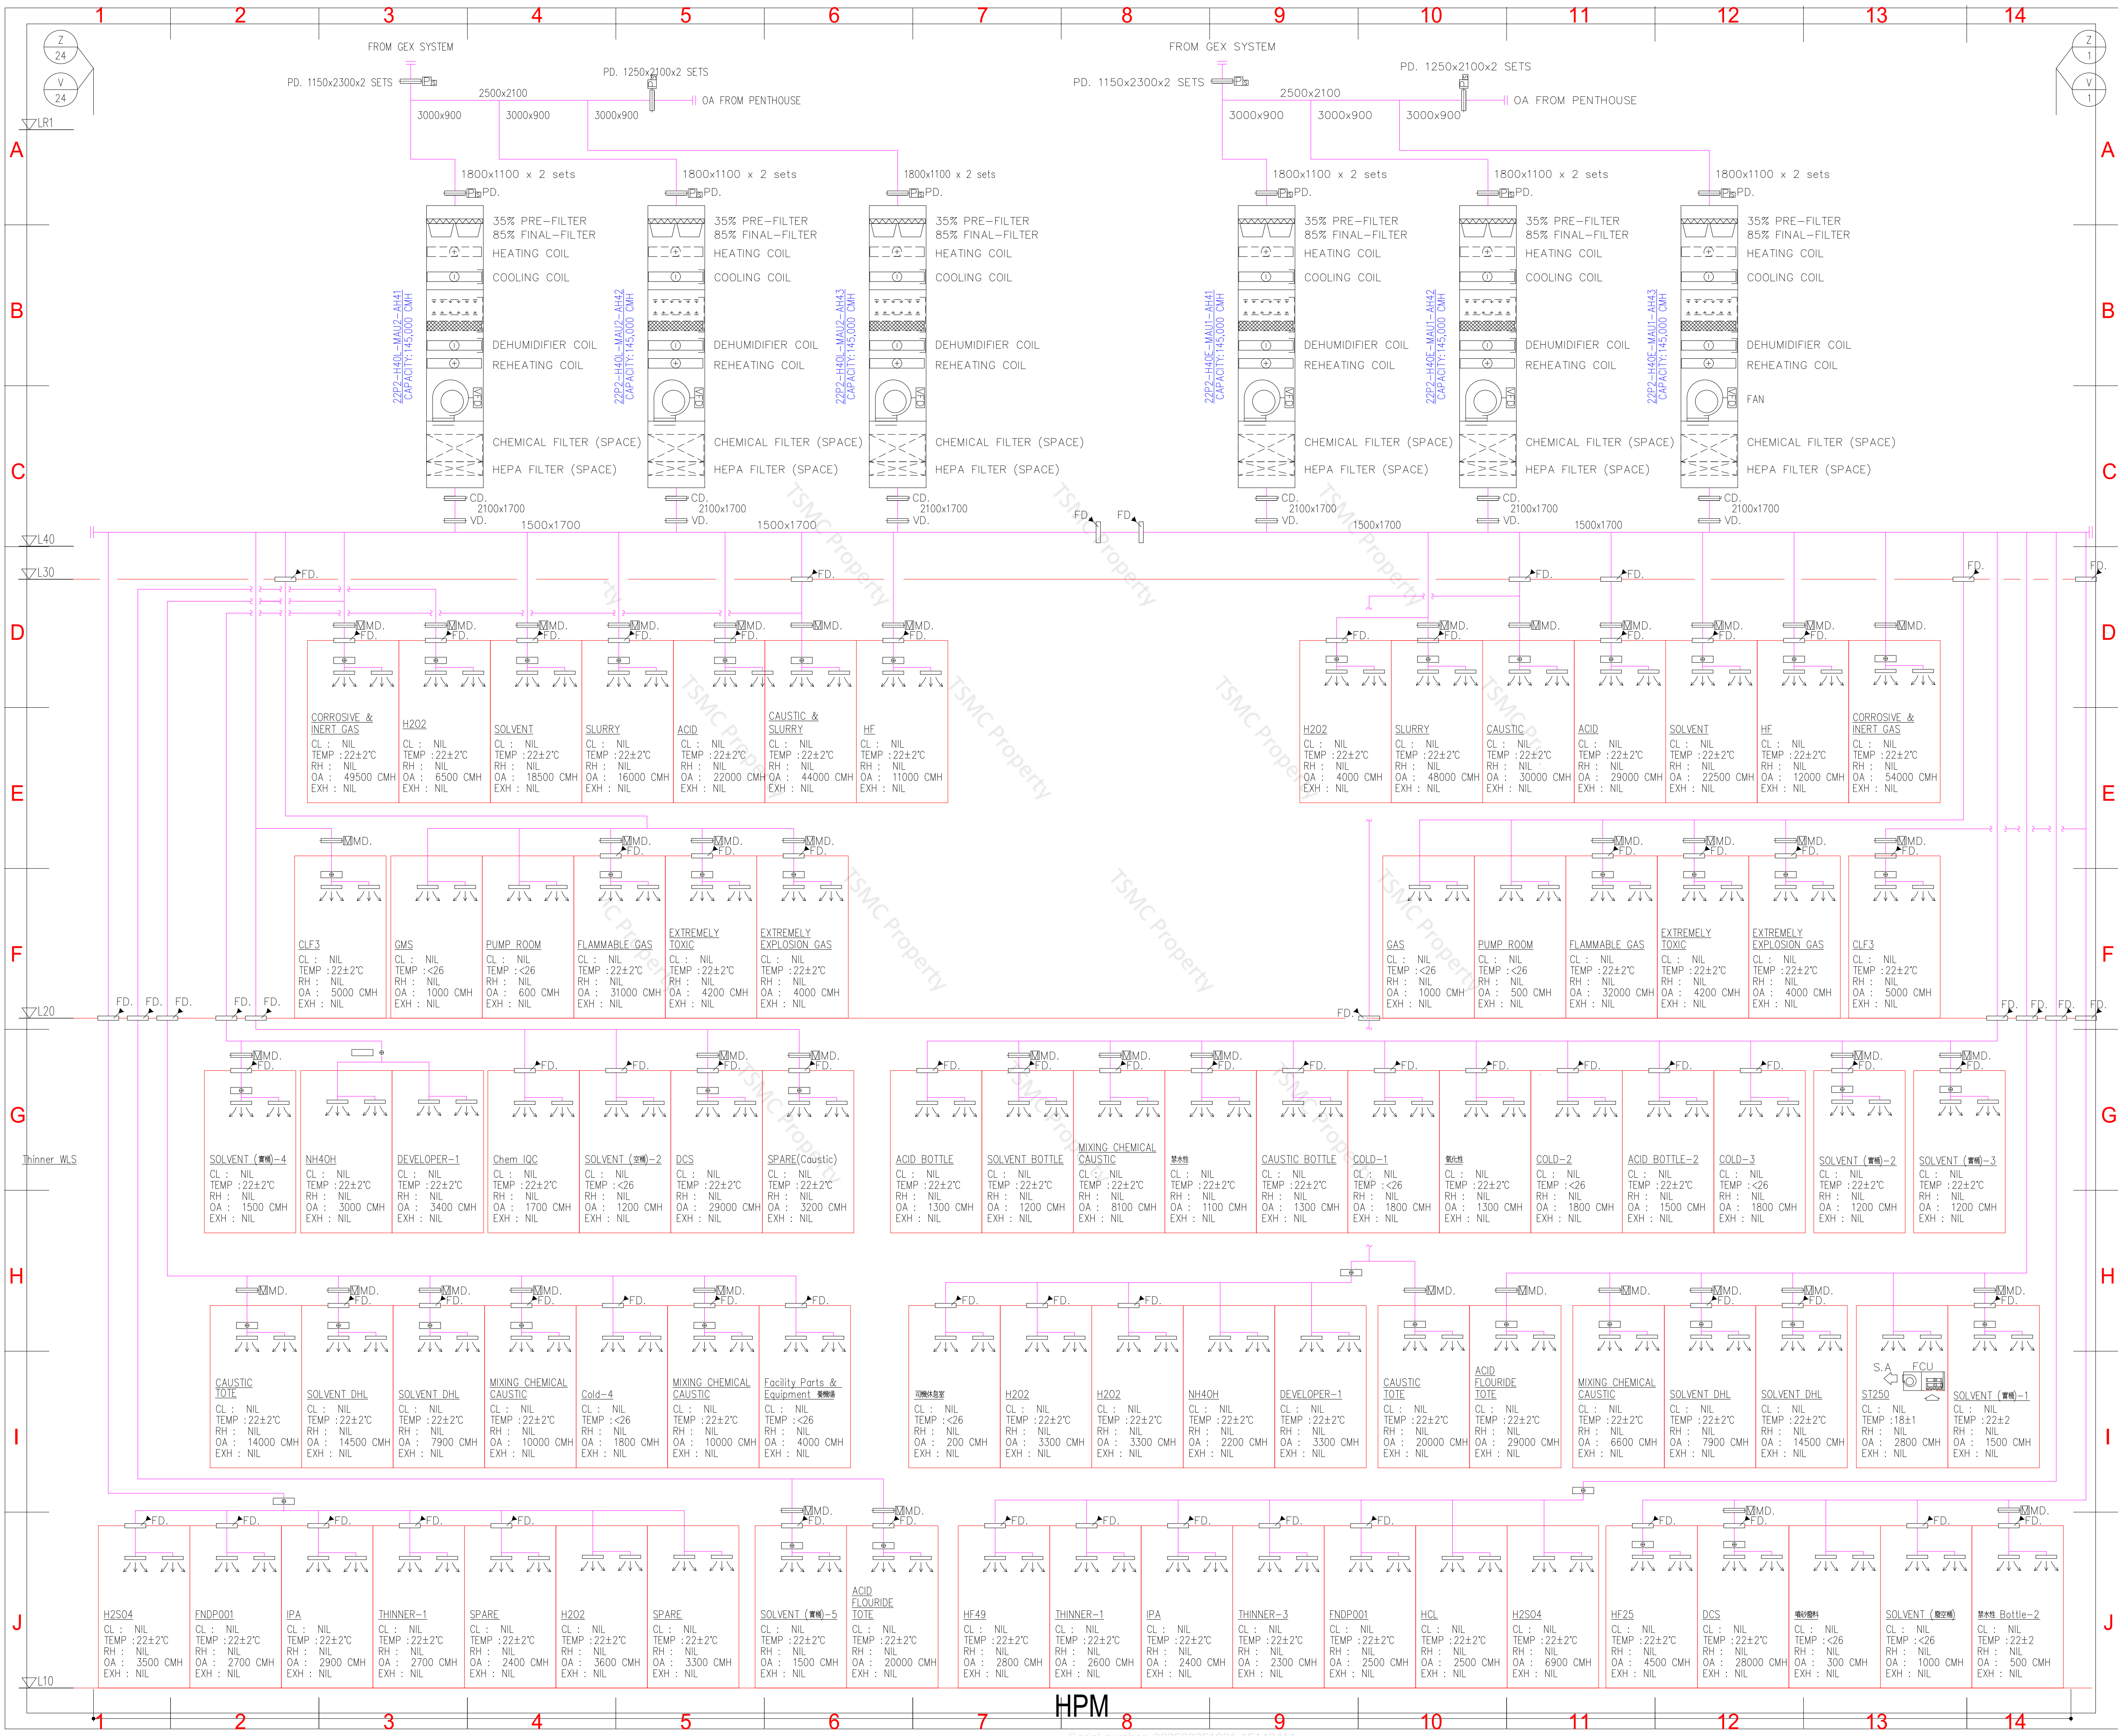

KEY PLANT

Building Code

- A: Office
- F: FAB
- H: HPM
- C: CUP
- G: Gas Yard & BSGS
- S: Supporting
- N: ASC
- W: Warehouse

版次	日期	修正者	修正
VER	DATE	REVIEW	REVISION

台灣積體電路製造股份有限公司
Taiwan Semiconductor Manufacturing Company, Ltd.

ACCEPTANCE REVIEWED	DATE	ACCEPTANCE REVIEWED	DATE

CONTRACTOR

uis 漢唐集成股份有限公司
United Integrated Services

DRAWN	ROGER YEH	DATE	2024/12/19	RECHECKED	Steven Yu	DATE	2024/12/19
DESIGNED <td>ROGER YEH<td>DATE<td>2024/12/19<td>APPROVED<td>JOSEPH LEE<td>DATE<td>2024/12/19</td></td></td></td></td></td></td>	ROGER YEH <td>DATE<td>2024/12/19<td>APPROVED<td>JOSEPH LEE<td>DATE<td>2024/12/19</td></td></td></td></td></td>	DATE <td>2024/12/19<td>APPROVED<td>JOSEPH LEE<td>DATE<td>2024/12/19</td></td></td></td></td>	2024/12/19 <td>APPROVED<td>JOSEPH LEE<td>DATE<td>2024/12/19</td></td></td></td>	APPROVED <td>JOSEPH LEE<td>DATE<td>2024/12/19</td></td></td>	JOSEPH LEE <td>DATE<td>2024/12/19</td></td>	DATE <td>2024/12/19</td>	2024/12/19




TITLE

FLOW DIAGRAM-
DUCTING SYSTEM
(2)
HPM


PROJECT	FAB22 Phase 2 PROJECT
PACKAGE NAME	MEP SYSTEM
DRAWING NAME	F22P2-M-2-H-04
SCALE	NOT TO SCALE
FILE NAME	F22P2-M-2-H-04

UNIT	mm
Rev	

出圖日期: 2024/12/19

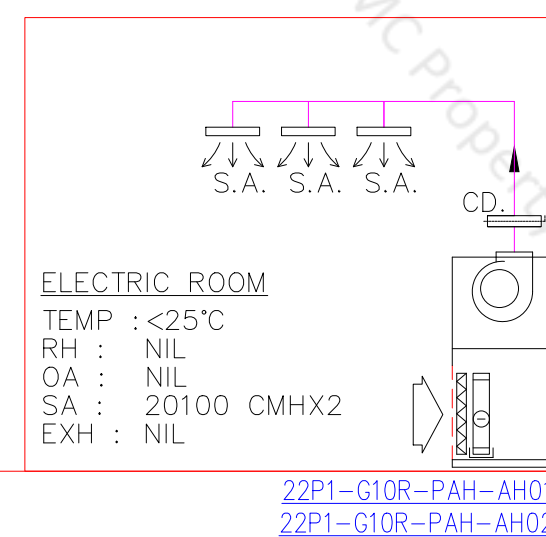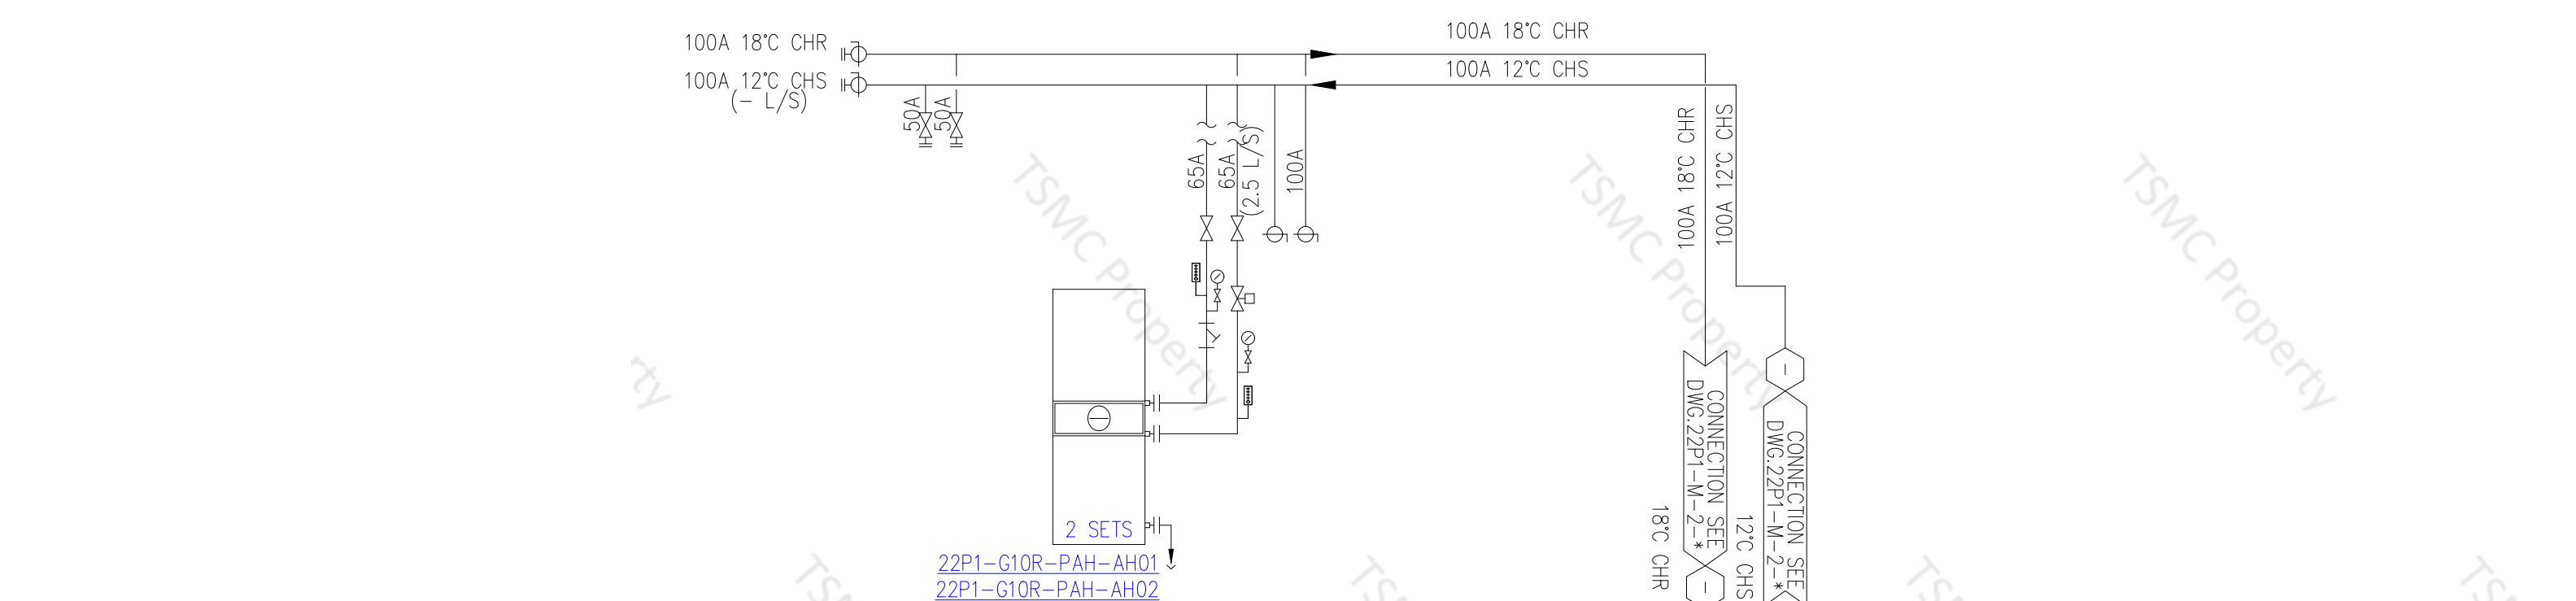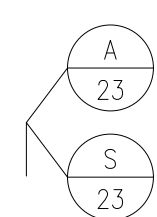

BSGS

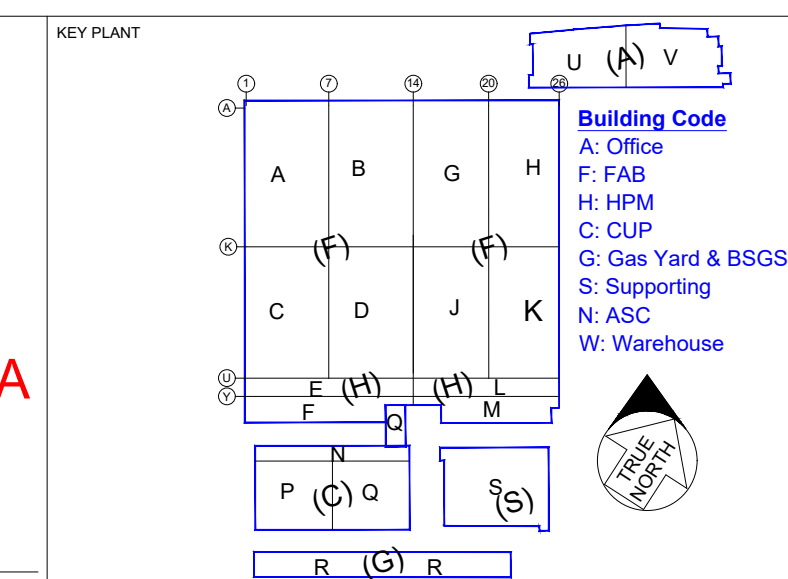[illegible]

版次 VER.	日期 DATE	修正者 REV BY	修 正 REVISION
------------	------------	---------------	-----------------



台灣積體電路製造股份有限公司
Taiwan Semiconductor Manufacturing Company, Ltd.

ACCEPTANCE REVIEWED	DATE	ACCEPTANCE REVIEWED	DATE
---------------------	------	---------------------	------

CONTRACTOR
 漢唐集成股份有限公司
 United Integrated Services

DRAWN	ROGER YEY	DATE	2024/12/11	RECHECKED	Steven Yu	DATE	2024/12/11
DESIGNED	ROGER YEY	DATE	2024/12/11	APPROVED	JOSEPH LEE	DATE	2024/12/11

TITLE

FLOW DIAGRAM -
PIPING & DUCTING SYSTEM
(1)
BSGS

PROJECT	FAB22 Phase 2 PROJECT	
PACKAGE NAME	MEP SYSTEM	
DRAWING NAME	F22P2-M-2-G-01	
SCALE	NOT TO SCALE	UNIT mm
FILE NAME	F22P2-M-2-G-01	Rev.

